


Map No. KANSAS Sec. 20 Twp. 10 R. 7E
 Well No. 1 - Thierer Farm
Healey et al Company

NORTH

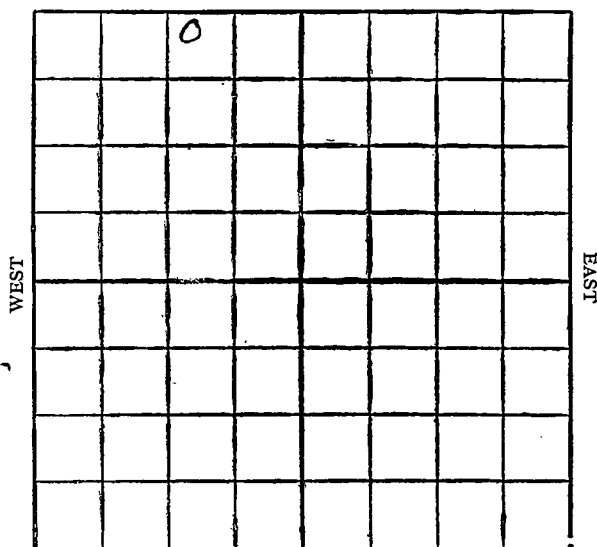

SOUTH

3020 TD

Location

Drilling Remarks

Rig Up

Drilling Remarks

RECORD

Cased in. ft.

Sand

Gas

Oil

Total Depth

PRODUCTION

1st 24 hrs. Nat.

1st 24 hrs. after shot

Gas cu. ft.

Dry Hole

Abandoned

Map No. **KANSAS** Sec. 20 Twp. 10 R. 7 E


Well No. 1 - Thiers Farm
Heeley et al Company

250 Ft. from N. Line

_____ Ft. from S. Line

1070 Ft. from E. Line

_____ Ft. from W. Line

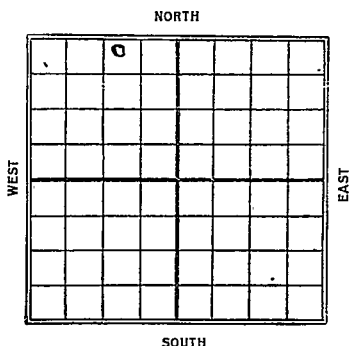

1928

Date	REPORT
8/28	S.D. 2965 - T.D.
9/4	— 1/23 —
9/12	— 1/30 —
9/19	— 2/6 —
9/26	— 2/13 —
10/3	— 2/20 —
10/10	— 2/27 —
10/17	— 3/6 —
10/24	— 3/13 —
10/31	— 3/20 —
11/7	— 3/27 —
11/14	— 4/2 —
11/21	— 4/9 —
11/28	— 4/16 —
12/5	— 4/24 —
12/12	— 5/1 —
12/19	— 5/8 —
12/26	— 5/15 —
1929	5/22 —
1/2	— 5/29 —
1/9	— 6/5 —
1/16	— 6/12 —

6/19- Orlg 3020'
6/26- " 3020'
7/2- S.D. 3025'
7/10 —
7/17 —
7/24 —
7/31 —
8/7 —
8/14 —
8/21 —
~~8/28~~ —
9/4 —
9/11 —
9/18 —
9/25 —
10/2 —
10/9 —
10/16 —

10/23- T.D. 3020'

Dry & Abandoned

KANSAS

Riley

Map No. _____ Sec. 20 Twp. 10 R. 7EWell No. 1 - Thierers FarmHeeley et al Company

NORTH

250 Ft. from N. Line

_____ Ft. from S. Line


1070 Ft. from E. Line

_____ Ft. from W. Line

WEST

EAST

SOUTH

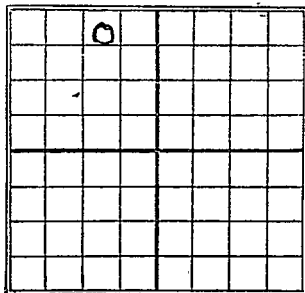

1927

Date

REPORT

6/29 Urelg 2883'
3" hole

7/7 Urelg 2883

7/13 " 2883

7/20 S.D. 2883

7/28 —

8/4 —

8/10 —

8/18 —

8/24 S.D. 3002

9/1 —

9/7 —

9/14 —

9/29 —

10/6 —

10/12 —

10/19 —

10/27 —

11/2 —

11/9 —

11/16 —

11/23 —

11/30 - SD. 3002

12/7 —

12/14 —

12/21 —

12/29 —

~~1928~~

1/5 —

1/11 —

1/18 —

1/26 —

2/2 —

2/9 —

2/16 —

2/23 —

3/1 —

3/8 —

3/16 —

3/22 —

3/29 —

4/5 —

4/12 —

4/19 —

4/26 —

5/3 —

5/10 —

5/18 —

5/24 —

5/31 —

6/7 — (Correction) T. D. 2965,
straight reaming 5" —

6/14 —

6/21 —

6/28 —

7/6 —

7/13 —

7/19 —

7/26 —

8/2 —

8/9 —

8/16 —

8/23 —

Map No. 70 Sec. 10 Twp. 7 R. 7

Well No. 1 Thieler
Hoeley et al Company

Contractor

FIRST REPORTS

SECTION PLAT

750 Ft. from N. Line

_____ Ft. from S. Line

1070 Ft. from E. Line

_____ Ft. from W. Line

	0		

Location _____

Rig up _____

Drilling and Remarks:

By 2883'

3" Hole

RECORD

Cased _____ in., _____ ft.

Sand _____

Gas _____

Oil _____

Total Depth _____

PRODUCTION

1st 24 hrs. Nat. _____

1st 24 hrs. after shot _____

Gas _____ Cu. Ft.

Dry Hole _____

Abandoned _____

Date

June 29 1927

CHAS. L. SHERWO

Sci

LS CORN

ST -

No Small Map

No Wall Map

Returned	
Cards	<i>None</i>
Tracing	<i>None</i>
Francis Map	
Scarborough Map	<i>X</i>
Moody Map	
Scarborough Plat Book	
Moody Plat Book	

103 KANS. Sec. 20 Twp. 10 R. 7 E

Well No. 1 Shierer
 Heeley Coal Company
 Contractor

COMPLETE

SECTION PLAT

	0		

250 Ft. from N. Line

Ft. from S. Line

1070 Ft. from E. Line

Ft. from W. Line

ABANDONED

Location

Rig up

Drilling and Remarks:

RECORD

Cased.....in.,ft.

Sand.....

Gas.....

Oil.....

Total Depth 3070

PRODUCTION

1st 24 hrs. Nat.....

1st 24 hrs. after shot.....

Gas.....Cu. Ft.

Dry Hole ✓

Abandoned ✓

Date

OCT 23 1929

192

CHAS. L. SHERWOOD

Scout

no small
no wall

Returned	<i>JD</i>
Cards	
Tracing	<i>CRK</i>
France Map	<i>none</i>
Scarborough Map	<i>X</i>
Moody Island	
Scarborough Flat Book	
Moody, P. + Book	