


15 087 00009 0000 KANSAS Jefferson

FORM 51 5M 4-41 PETROL

Section 20 Township 10 Range 20-E

Well No. #1 Stroud

Company Mosbacher et al
(Misc.)

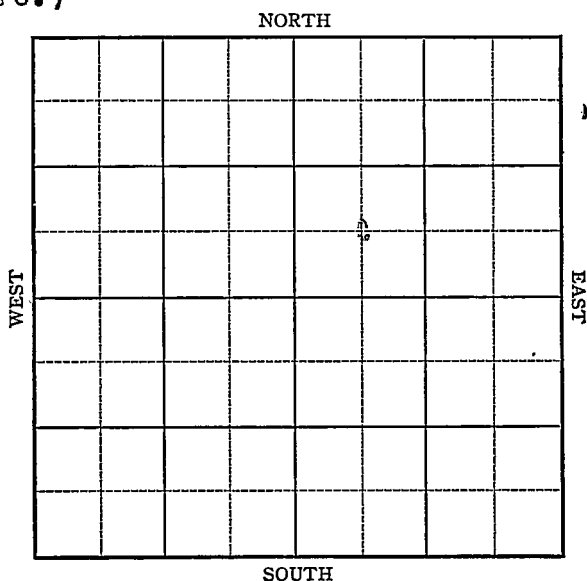

Sec. 20 Twp. 10 R. 20-E

Well No. #1 Stroud Farm


Mosbacher et al _____ Company

Ft. from N. Line

660 Ft. from S. Line

_____Ft. from E. Line

660 _____ Ft. from W. Line

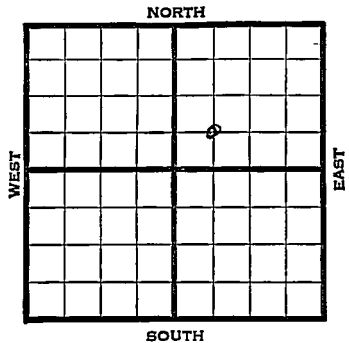

(Miscellaneous)

[illegible]

KANSASMap No. NM Sec. 20 Twp. 10 R. 20EWell No. 1 StroudMosbacher et al Company**FIRST REPORT** Contractor

C SW NE

 Ft. from N. Line660 Ft. from S. Line Ft. from E. Line660 Ft. from W. Line

SECTION PLAT

		o	

MISCELLANEOUS

Location Rig up

Drilling and Remarks:

Cable

RECORD

Cased in., ft.Sand Gas Oil Total Depth

PRODUCTION

1st 24 hrs. Nat. 1st 24 hrs. after shot Gas Cu. Ft.Dry Hole Abandoned

Date

AUG 6 1941 19 S. J. LEWIS Scout

Map No. NM Sec. 20 Twp. 10 R. 20EWell No. 1 StroudMosbacher etal CompanyABANDONED Contractor

C SW NE

 Ft. from N. Line660 Ft. from S. Line Ft. from E. Line660 Ft. from W. Line

MISCELLANEOUS

SECTION PLAT

		a	

Location Rig up

Drilling and Remarks:

Miss 1862No shows

RECORD

Cased in., ft.Sand Gas Oil Total Depth 1531

PRODUCTION

1st 24 hrs. Nat. 1st 24 hrs. after shot Gas Cu. Ft.Dry Hole Abandoned

Date

SEP 17 1941 19 S. J. LEWIS Scout