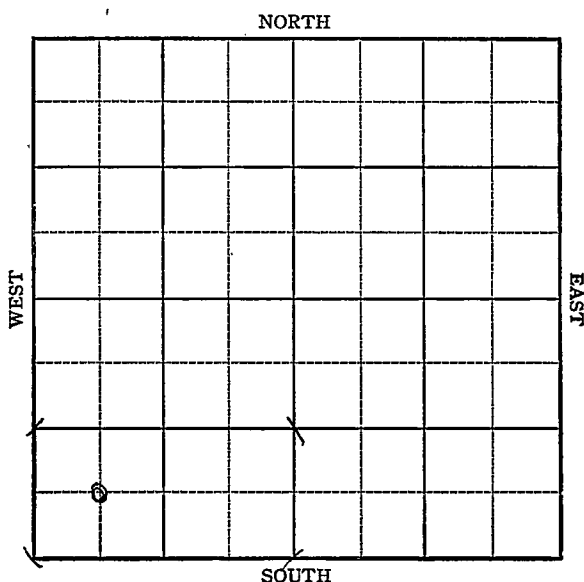


KANSAS


Jefferson

FORM 51 5M PETROL

Section 21 Township 10 Range 18-EWell No. #1 MoonCompany McLaughlin

KANSAS

Jefferson

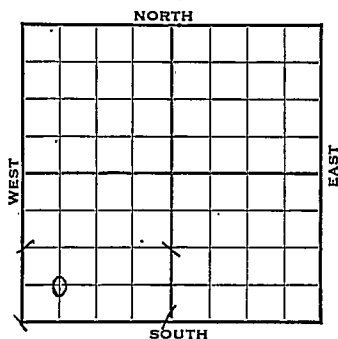Sec. 21 Twp. 10 R. 18-EWell No. #1 Moon FarmMcLaughlin Company Ft. from N. Line660 Ft. from S. Line Ft. from E. Line660 Ft. from W. Line

1943	El. 1038	REPORT
8/18	Machine	
8/25	"	
9/1	10" @ 38'	Drlg. 280'
9/8	"	Drlg. 670'
9/15		Drlg. 800'
9/22		Drlg. 1050'
		8" @ 898'
9/29		Drlg. 1460'
		6" @ 1445'
10/6		Miss 1648'
		T.D. 1695'
		ABANDONED

KANSAS
 Map No. 777 Sec. 21 Twp. 10 R. 18E

Well No. 1 Moon

McLaughlin Company

ABANDONED Contractor

C SW SW

SECTION PLAT

 Ft. from N. Line

660 Ft. from S. Line

 Ft. from E. Line

660 Ft. from W. Line

McLouth Pool

Location

Rig up

Drilling and Remarks:

Wire 1648

RECORD

Cased in., ft.

Sand

Gas

Oil

Total Depth 1695

PRODUCTION

1st 24 hrs. Nat.

1st 24 hrs. after shot

Gas Cu. Ft.

Dry Hole

Abandoned

Date

OCT 6 1943 19 S. J. LEWIS Scout

KANSAS

Map No. NM Sec. 21 Twp. 10 R. 18EWell No. 1 Moon

McLaughlin

Company

FIRST REPORT

Contractor

C SW SW

Ft. from N. Line

660

Ft. from S. Line


Ft. from E. Line

660

Ft. from W. Line

McLouth Pool

SECTION PLAT

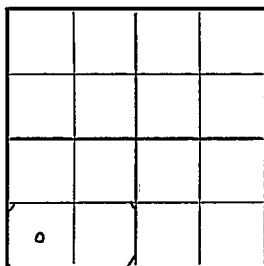

Location

Rig up

Drilling and Remarks:

Mach.

RECORD

Cased _____ in., _____ ft.

Sand _____

Gas _____

Oil _____

Total Depth _____

PRODUCTION

1st 24 hrs. Nat. _____

1st 24 hrs. after shot _____

Gas _____ Cu. Ft.

Dry Hole _____

Abandoned _____

Date

AUG 1 8 1943 19

S. J. LEWIS Scout