

11-10-20

STATE CORPORATION COMMISSION OF KANSAS
OIL & GAS CONSERVATION DIVISION
WELL COMPLETION OR RECOMPLETION FORM
ACO-1 WELL HISTORY
DESCRIPTION OF WELL AND LEASE

Operator: License # 3070
Name Mid. Gulf, Inc.
Address P.O. Box 1648
City/State/Zip Brenham, TX 77833

Purchaser.....

Operator Contact Person Derrell Krebs
Phone (409) 836-4576

Contractor: License # 4423
Name Van Drilling, Inc.

Wellsite Geologist Dix R. Turnbow
Phone (409) 836-4576

Designate Type of Completion

☒ New Well ☐ Re-Entry ☐ Workover
☐ Oil ☐ SWD ☐ Temp Abd
☐ Gas ☐ Inj ☐ Delayed Comp.
☒ Dry ☐ Other (Core, Water Supply etc.)
If **OWWO**: old well info as follows:

Operator
Well Name
Comp. Date Old Total Depth.....

WELL HISTORY

Drilling Method:

☒ Mud Rotary ☐ Air Rotary ☐ Cable

Spud Date 2-24-87 Date Reached TD 4-26-87 Completion Date N/A

Well Depth 1223 PBTD N/A

Amount of Surface Pipe Set and Cemented at 43 feet
Multiple Stage Cementing Collar Used? ☐ Yes ☒ No

If yes, show depth set.....feet

If alternate 2 completion, cement circulated from 63 feet depth to 0 w/ 18 SX cmt

Cement Company Name Provided By Drilling Contractor
Invoice # N/A

API No. 15-103-70, 831
County Leavenworth
NE NW NE Sec. 11 Twp 10 S Rge. 22 East West

4950 Ft North from Southeast Corner of Section
1650 Ft West from Southeast Corner of Section
(Note: Locate well in section plat below)


Lease Name Kraft Well # 2

Field Name.....

Producing Formation N/A

Elevation: Ground 985 KB 987

Section Plat

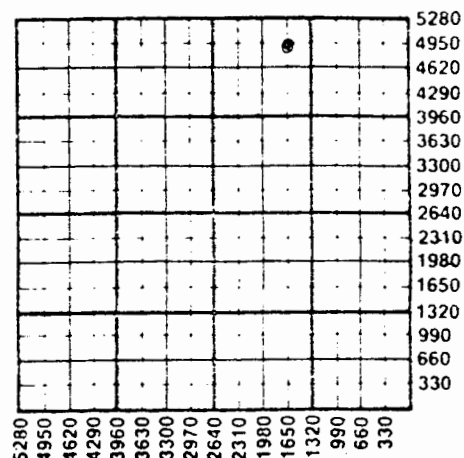

WATER SUPPLY INFORMATION

Disposition of Produced Water: ☒ Disposal
Docket # ☐ Repressuring

Questions on this portion of the ACO-1 call:

Water Resources Board (913) 296-3717

Source of Water:

Division of Water Resources Permit #.....

Groundwater.....Ft North from Southeast Corner
(Well)Ft West from Southeast Corner of
Sec Twp Rge East West

Surface Water.....Ft North from Southeast Corner
(Stream, pond etc).....Ft West from Southeast Corner
Sec Twp Rge East West

☒ Other (explain) Purchased
(purchased from city, R.W.D. #)

INSTRUCTIONS: This form shall be completed in triplicate and filed with the Kansas Corporation Commission, 200 Colorado Derby Building, Wichita, Kansas 67202, within 120 days of the spud date of any well. Rule 82-3-130, 82-3-107 and 82-3-106 apply.

Information on side two of this form will be held confidential for a period of 12 months if requested in writing and submitted with the form. See rule 82-3-107 for confidentiality in excess of 12 months.

One copy of all wireline logs and drillers time log shall be attached with this form. Submit CP-4 form with all plugged wells. Submit CP-111 form with all temporarily abandoned wells.