

KANSAS

Jefferson


FORM 51 5M 4-41 PETROL

15 087 00029 0000

Section 22 Township 10 Range 19-E

Well No. #1 Riling

Company Workman & Sherrod
(Misc.)

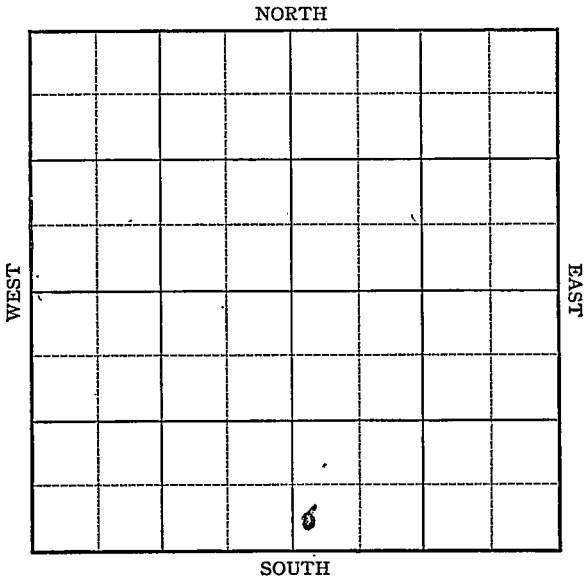

Sec. 22 Twp. 10 R. 19-E

Well No. #1 Riling Farm

Workman & Sharrod Company


(Miscellaneous)

 Ft. from N. Line

330 Ft. from S. Line

 Ft. from E. Line

330 Ft. from W. Line

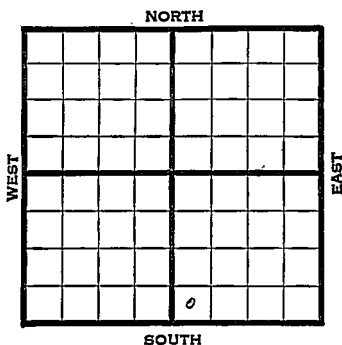

1941	REPORT
8/6	Mach. Spud
8/15	"
8/21	8" - 105' Drlg. 450'
8/28	450' Tight hole.
9/4	Drlg. 748'
9/11	SD 748'
9/18	Drlg. 1153'
9/25	Drlg. 1200'
10/2	SD 1200'
10/9	"
10/16	5" - 1200' H.F.W. 1210'
	U.R. 5".
10/23	1285' U.R. 5".
10/30	Bart. ^{1559'} 1572' 1½ M gas.
	Run casing.
11/6	Bart. 1559' (Corrected)
	5" - 1228' U.R. 5".
11/13	" " "
11/20	" " "
11/26	" " "
12/4	Shut down. OVER
12/11	Sand 1557-87 TD 5" @ 1505

1941
12/11 119,000 cu. ft. gas.

12/18 TD 1605 PB

12/23 Sand 1557'
5" - 1505"
T.D. 1605'
P.B. 1580'
250,000 cu. ft. gas.

COMPLETED

KANSASMap No. N/M Sec. 22 Twp. 10 R. 10EWell No. 1 RilingWorkman & Sherrod CompanyFIRST REPORT Contractor

SECTION PLAT

SW SE

 Ft. from N. Line330 Ft. from S. Line Ft. from E. Line330 Ft. from W. Line

6

MISCELLANEOUS

Location Rig up

Drilling and Remarks:

Mach. Spud

RECORD

Cased in., ft.Sand Gas Oil Total Depth

PRODUCTION

1st 24 hrs. Nat. 1st 24 hrs. after shot Gas Cu. Ft.Dry Hole Abandoned

Date

AUG 6 1941 19 S. J. LEWIS Scout

Jefferson **KANSAS**Map No. MM Sec. 22 Twp. 10 R. 19EWell No. 1 RilingWorkman & Sherrod Company**COMPLETED**

Contractor

SW SE

SECTION PLAT

 Ft. from N. Line330 Ft. from S. Line Ft. from E. Line330 Ft. from W. Line

MISCELLANEOUS

RECORD

Location Cased in., ft.Rig up Sand

Drilling and Remarks:

Gas Oil Total Depth 1605

PRODUCTION

1st 24 hrs. Nat. 1st 24 hrs. after shot Gas Cu. Ft.Dry Hole Abandoned

Date

DEC 23 1941

19

S. J. LEWIS Scout