

15 103 00029 0000 Leavenworth

KANSAS

26

10S

20E


SECTION \_\_\_\_\_ TOWNSHIP \_\_\_\_\_ RANGE \_\_\_\_\_

#1 Hurlbut

WELL NO. \_\_\_\_\_

COMPANY W.S. Fees Jr., & Garfield Richards

NORTH

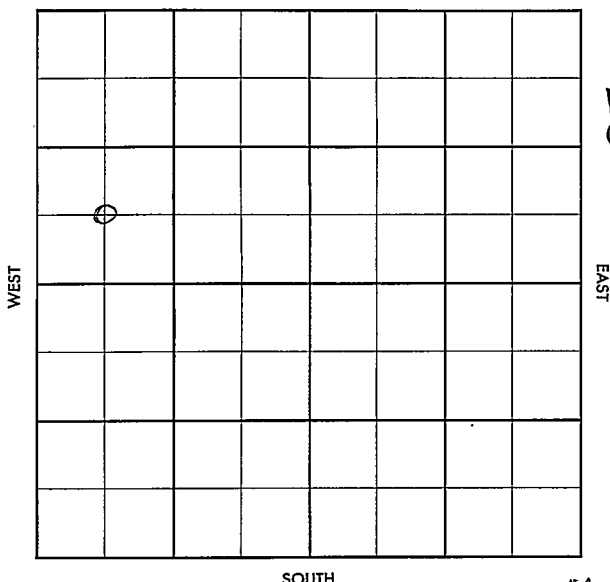

|      |      |     |
|------|------|-----|
| SEC. | TWP. | R.  |
| 26   | 10   | 20E |

WELL NO.

#1 Hurlbut

FARM

COMPANY

W.S. Fees Jr. &amp; Garfield Richards

CONTRACTOR

Co. Rotary

WILDCAT


\_\_\_\_\_ FT. FROM N. LINE

\_\_\_\_\_ FT. FROM S. LINE

\_\_\_\_\_ FT. FROM E. LINE

\_\_\_\_\_ FT. FROM W. LINE

C SW NW

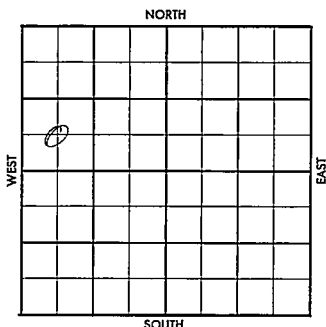

|      | ELEVATION             | REPORT |
|------|-----------------------|--------|
| 1956 | 1092 $\frac{1}{2}$ RB |        |

8-29

Comm. 8-13-56

8" @ 50

Core 1390-1410; full rec. sdy shale;

Core 1410-29 full rec. sdy shale;

RTD 1560;

No log;

D&amp;A

B.Oread 110'; KC. 378'; BKG 715';

McLouth 1405'; Miss Ls. 1434';

TD 1560'

FIRST REPORT

ABANDONED

$$\begin{array}{r}
 1092 \\
 715 \\
 \hline
 +377
 \end{array}$$

(No County Map)

County Leavenworth Elev. 1092 $\frac{1}{2}$  RB  
 Sec. 26 Twp. 10S Rge. 20E  
 Company W. S. Fees Jr. & Garfield Richards  
 Farm Name Hurlbut No. 1

| TOPS             | DEPTH       | LOG | DATUM | Loc. in Sec. |
|------------------|-------------|-----|-------|--------------|
| Anh.             |             |     |       | C SW NW      |
| TP. <u>Oread</u> | <u>110</u>  |     |       | DS - All     |
| Tr.              |             |     |       | of Sec.      |
| Dg.              |             |     |       |              |
| BL.              |             |     |       |              |
| L.               |             |     |       | Geol.        |
| K.C.             | <u>378</u>  |     |       | Contr.       |
| B.K.C.           | <u>715</u>  |     |       | Co. rotary   |
| <u>McLouth</u>   | <u>1405</u> |     |       | Pool         |
| C.               |             |     |       | Wildcat      |
| <u>Miss ls.</u>  | <u>1434</u> |     |       |              |
| M.               |             |     |       |              |
| K.               |             |     |       |              |
| Mz.              |             |     |       |              |
| Me.              |             |     |       |              |
| V.               |             |     |       |              |
| S.               |             |     |       |              |
| S.               |             |     |       |              |
| A.               |             |     |       |              |
| R.               |             |     |       |              |
| Pe.              |             |     |       |              |
| G.               |             |     |       |              |
| TD.              | <u>1560</u> |     |       |              |

Loc. in Sec.

C SW NW

DS - All

of Sec.

Geol.

Contr.

Co. rotary

Pool

Wildcat

FIRST REPORT

0

AUG 29 '56

ABANDONED

Date Comm. 8-13-56

8" 50; core 1390-1410; fill rec. sdy shale;  
core 1410-29 full rec. sdy shale; RTD 1560;  
no log; D & A

2221 5 430

G. R.