

Riley Co

Map No. Kansas Sec. 26 Twp. 10 R 6 E

Well No. 1 marks Farm


Mutual Oil Company

1120 Ft. from N. Line

_____ Ft. from S. Line

1120 Ft. from E. Line

_____ Ft. from W. Line

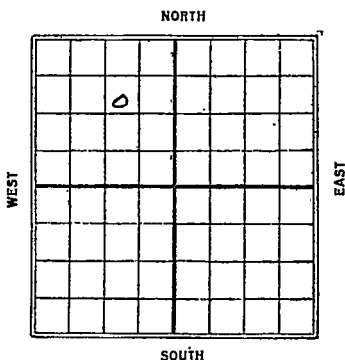

Date	REPORT
1925	
8/20	S/L 2400
8/26	—
9/3	—
9/11	—
9/24	—
10/1	same
10/8	—
10/16	—
10/22	—
10/29	—
11/6	—
11/13	—
11-19	—
11-27	—
12/3	—
12/10	S/O 2400
12/17	—
12/23	—
12/31	—
1926	
1/8	—
1/14	—
1/20	—

Riley Co.

Map No. 70 KANSAS Sec. 26 Twp. 10 R. 6E

Well No. 1 MARKS

Mutual Oil Co Company

Contractor

FIRST REPORTS

SECTION PLAT

1120 Ft. from N. Line

_____ Ft. from S. Line

1120 Ft. from E. Line

_____ Ft. from W. Line

	0		

Location _____

Rig up _____

Drilling and Remarks:

Drly 2400'

RECORD

Cased _____ in., _____ ft.

Sand _____

Gas _____

Oil _____

Total Depth _____

PRODUCTION

1st 24 hrs. Nat. _____

1st 24 hrs. after shot _____

Gas _____ Cu. Ft.

Dry Hole _____

Abandoned _____

Date

AUG 20 1925

CHAS. L. SHERWOOD
Scout

Map No. ^{70 map} KANSAS Sec. ^{Riley} 26 Twp. 10 R. 6E

Well No. 1 ^{Marks} Mutual Oil Co Company

Contractor

COMPLETED

SECTION PLAT

1120 Ft. from N. Line

----- Ft. from S. Line

1120 Ft. from E. Line

----- Ft. from W. Line

	0		

ABANDONED

Location -----

Rig up -----

Drilling and Remarks:

JJA

2400

RECORD

Cased ----- in., ----- ft.

Sand -----

Gas -----

Oil -----

Total Depth 2400

PRODUCTION

1st 24 hrs. Nat. -----

1st 24 hrs. after shot -----

Gas ----- Cu. Ft.

Dry Hole

Abandoned

Date

AUG 18 1927

CHAS. L. SHERWOOD

Scout