


Section 27 Township 10 Range 19 E

Well No. # 1 Long ●

Company Miners Oil

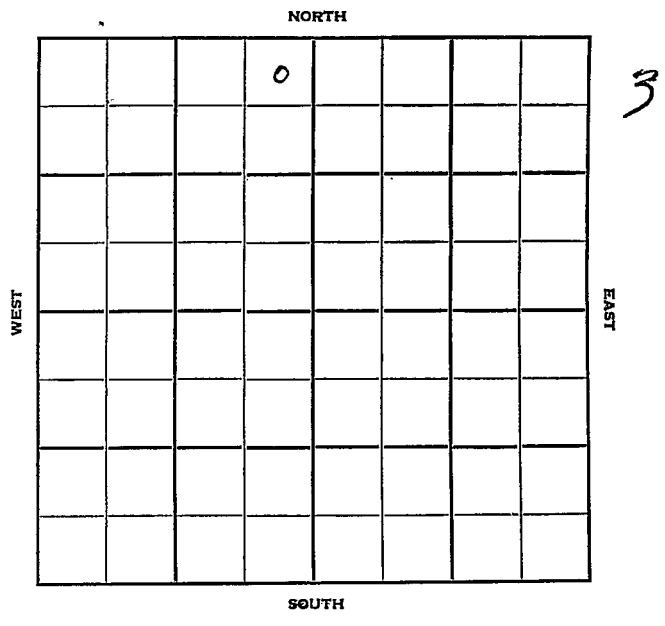

Jefferson

KANSAS

Sec. 27 Twp. 10 R. 19E ✓

Well No. #1 Long Farm

Miners Oil Company

Brown & Farmer - Contr. Contractor

Wildcat


330' Ft. from N. Line

_____ Ft. from S. Line

330' Ft. from E. Line

_____ Ft. from W. Line

NE NE NW

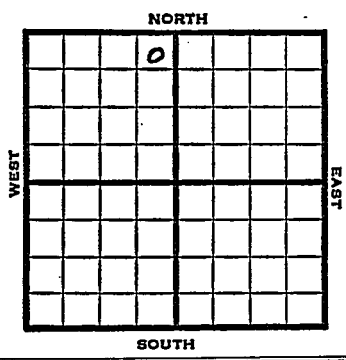

1951 11201 REPORT

9/19
 McClouth Sd 1592
 Miss L 1644
 Kh 2006
 Hunt 2058
 Silvan 2227
 Viola 2242-70 TD
 D&A

**FIRST REPORT
ABANDONED**

County Jefferson State Kansas

Sec. 27 (Blk. Twp.) 10 (Sur. Rge.) 19E Map No.

Operator Miners Oil

Well No. 1 Farm Long

Elev. Location NE NE NW

		0			

~~FIRST REPORT~~
~~ABANDONED~~

330 Ft. From N Line NW

330 Ft. From E Line Quarter

Ist. Report SEP 19 1951

Completion SEP 19 1951

Remarks

Brown & Farmer - Contr.

Spudding Date

Drig. Data Wildcat

McClouth Sd. 1592 Miss L 1644 Kh 2006

Hunt 2058 Silvan 2227 Viola 2242-70 T.D.

D&A