

KANSAS

Leavenworth

FORM 51 5M 4-41 PETROL


Section 3 Township 10 Range 20-E

Well No. #1 Moore

Company Longwell et al

Miscellaneous

NORTH

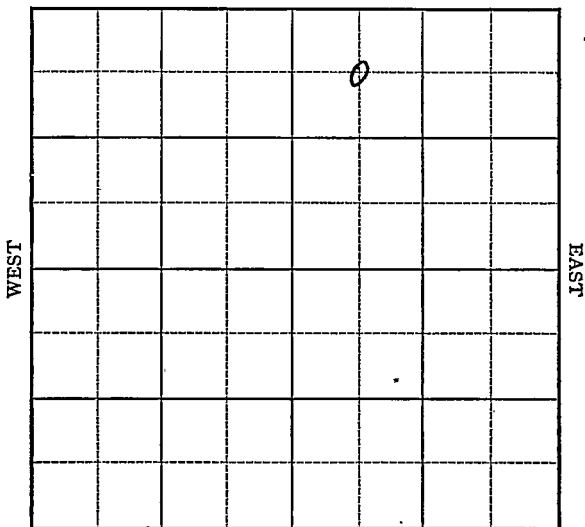

SOUTH

Sec. 3 Twp. 10 R. 20-E

Well No. #1 Moore Farm

Longwell et al Company


(Miscellaneous)

660 Ft. from N. Line

_____ Ft. from S. Line

_____ Ft. from E. Line

660 Ft. from W. Line

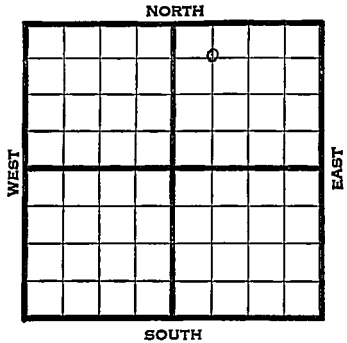

1941

REPORT

8/13 Drlg. 264'

8/21 10" - 40' Drlg. 1340'

8/27 Miss. 1493'

T.D. 1635'

H.F.W.

ABANDONED

KANSAS

Leavenworth

Map No. NM Sec. 3 Twp. 10 R. 20E

Well No. 1 Moore

Longwell etal Company

W. T. S. D. P. A. D. T. Contractor

SECTION PLAT

C NW NE

		o	

660 Ft. from N. Line

_____ Ft. from S. Line

_____ Ft. from E. Line

660 Ft. from W. Line

MISCELLANEOUS

Location _____

Rig up _____

Drilling and Remarks:

Drlg. 264

^

RECORD

Cased _____ in., _____ ft.

Sand _____

Gas _____

Oil _____

Total Depth _____

PRODUCTION

1st 24 hrs. Nat. _____

1st 24 hrs. after shot _____

Gas _____ Cu. Ft.

Dry Hole _____

Abandoned _____

Date

AUG 13 1941

S. J. LEWIS Scout

Map No. _____ Sec. 3 Twp. 10 R. 20EWell No. 1 MooreLongwell etal CompanyABANDONED Contractor

C NW NE

660 Ft. from N. Line

_____ Ft. from S. Line

_____ Ft. from E. Line

660 Ft. from W. Line

MISCELLANEOUS

SECTION PLAT

		o	

Location _____

Rig up _____

Drilling and Remarks:

*Miss 1493**NFW.*

RECORD

Cased _____ in., _____ ft.

Sand _____

Gas _____

Oil _____

Total Depth 1635

PRODUCTION

1st. 24 hrs. Nat. _____

1st 24 hrs. after shot _____

Gas _____ Cu. Ft.

Dry Hole _____

Abandoned _____

Date

AUG 27 1941₁₉S. J. LEWIS

Scout