

KANSAS

Jefferson

15 087 00022 0000


FORM 51 5M 4-41 PETROL

Section 3 Township 10 Range 19-E

Well No. 1 Chavanne

Company E. B. Jackson

NORTH Miscellaneous

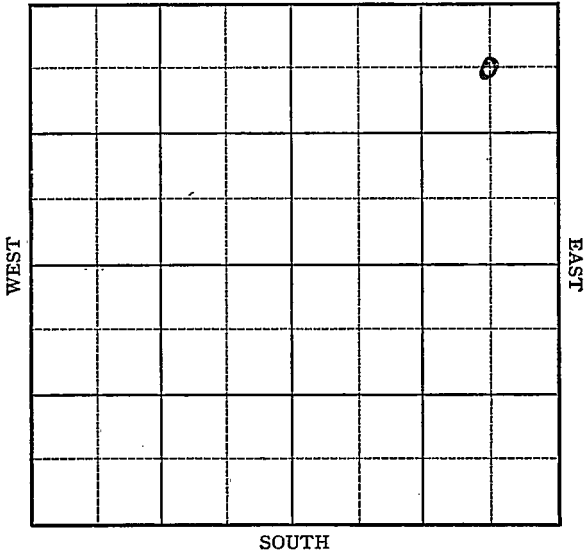

Map No. _____ Sec. 3 Twp. 10 R. 19EWell No. 1 ChavanneE. B. Jackson Company

Contractor

FIRST REPORT

C NE NE

SECTION PLAT660 Ft. from N. Line

_____ Ft. from S. Line

660 Ft. from E. Line

_____ Ft. from W. Line

			o

MISCELLANEOUS

Location _____

Rig up _____

Drilling and Remarks:

10" - 86'Drlg. 150**RECORD**

Cased _____ in., _____ ft.

Sand _____

Gas _____

Oil _____

Total Depth _____

PRODUCTION

1st 24 hrs. Nat. _____

1st 24 hrs. after shot _____

Gas _____ Cu. Ft.

Dry Hole _____

Abandoned _____

Date

AUG 27 1941 19S. J. LEWIS Scout

Map No. Sec. 3 Twp. 10 R. 19EWell No. 1 ChavanneE. B. Jackson CompanyABANDONED Contractor

C NE NE

660 Ft. from N. Line Ft. from S. Line660 Ft. from E. Line Ft. from W. Line

SECTION PLAT

			o

MISCELLANEOUS

Location Rig up

Drilling and Remarks:

*Wils 1595**Water*

RECORD

Cased in., ft.Sand Gas Oil Total Depth 1638

PRODUCTION

1st 24 hrs. Nat. 1st 24 hrs. after shot Gas Cu. Ft.Dry Hole Abandoned

Date

SEP 24 1941 19 S. J. LEWIS Scout