


Section 3 Township 10 Range 20-E

Well No. #4 Bankers Life

Company Longwell etal.

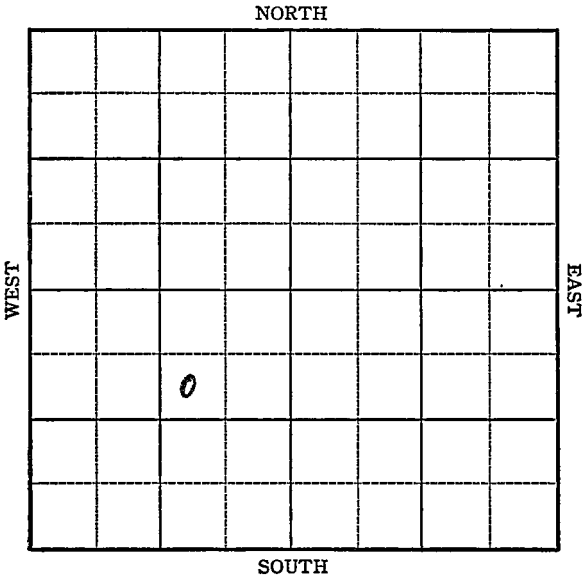

Sec. 3 Twp. 10 R. 20-E

Well No. #4 Bankers Life Farm

Longwell et al Company.


(Misc.)

990 Ft. from N. Line

_____ Ft. from S. Line

990 Ft. from E. Line

_____ Ft. from W. Line

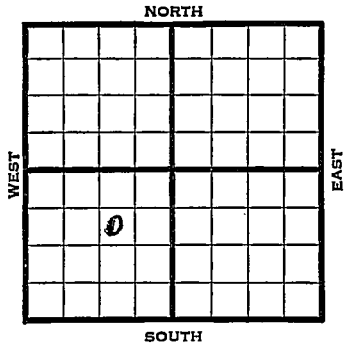

1941	REPORT
11/19	Spud.
11/26	Drilg. 900'
12/4	Sand 1413' T.D. 1441'
	Run csg.
12/11	Sand 1406 corrected 5" @ 1405
	WD 1456-60 qts. 1426@46
	300' oil 14 hr.
12/18	" " "
12/24	" " "
12/31	" " "
1942	
1/7	Sand 1406'
	5" - 1405'
	T.D. 1456'
	Shot 60 qts. 1426-46'
	Potential 40 bbls., pump.
	26. Gravity
	COMPLETED

Map No. MM Sec. 3 Twp. 10 R. 20E

Well No. 4 Bankers Life
Longwell etal. Company

FIRST REPORT Contractor

SW NE SW

990 Ft. from N. Line

_____ Ft. from S. Line

990 Ft. from E. Line

_____ Ft. from W. Line

SECTION PLAT

	o		

MISCELLANEOUS

Location _____

Rig up _____

Drilling and Remarks:

Spud

RECORD

Cased _____ in., _____ ft.

Sand _____

Gas _____

Oil _____

Total Depth _____

PRODUCTION

1st 24 hrs. Nat. _____

1st 24 hrs. after shot _____

Gas _____ Cu. Ft.

Dry Hole _____

Abandoned _____

Date

NOV 1 9 1941 19

S. J. LEWIS Scout

Map No. MM Sec. 3 Twp. 10 R. 20E

Well No. 4 Bankers Life

Longwell et al. Company

COMPLETED Contractor

SW NE SW

SECTION PLAT

990 Ft. from N. Line

_____ Ft. from S. Line

990 Ft. from E. Line

_____ Ft. from W. Line

	o		

MISCELLANEOUS

Location _____

Rig up _____

Drilling and Remarks:

Sand. 1406
5" @ 1405
609 to 1426-46
Pump 40 P.S.

260 Gr

RECORD

Cased _____ in., _____ ft.

Sand _____

Gas _____

Oil _____

Total Depth 1456

PRODUCTION

1st 24 hrs. Nat. _____

1st 24 hrs. after shot _____

Gas _____ Cu. Ft.

Dry Hole _____

Abandoned _____

Date

JAN 7 1942 19

S. J. LEWIS Scout