

KANSAS

Section 3 Township 10 Range 20EWell No. #9 Banker's LifeCompany Miller

0									

NORTH

WEST

EAST

SOUTH

7

Sec. 3 Twp. 10 R. 20E

Well No. #9, Banker's Life Farm

Miller Company

McLouth


330 Ft. from N. Line

 Ft. from S. Line

 Ft. from E. Line

3300 Ft. from W. Line

NW/C

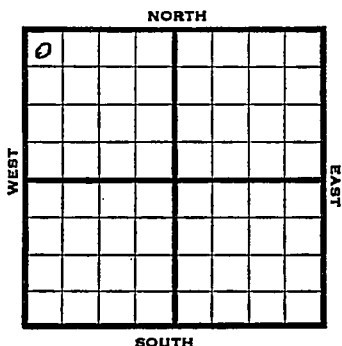

1946

REPORT

6/12	Location		
6/18	"		
6/26	Drilg 200'		
7/3	10" @ 22'		
	8" @ 800'		
	6" @ 1300'		
	SD 1433		
	TD So 5" @ 1431 WOC		
7/9	"	"	"
7/16	"	"	"
7/23	"	"	"
7/30	"	"	"
8/6	"	"	"
8/14	Sand 1433		
	TD 1480'		

ABANDONED

KANSASKansas Pool Name McLouthMap No. no map Sec. 3 Twp. 10 R. 20EWell No. 9 Banker's LifeMiller CompanyFIRST REPORT Contractor

NW/C

SECTION PLAT

0			

330 Ft. from N. Line Ft. from S. Line Ft. from E. Line330 Ft. from W. LineLeavenworth CountyLocation XRig up

Drilling and Remarks:

RECORD

Cased in., ft.Sand Gas Oil Total Depth

PRODUCTION

1st 24 hrs. Nat. 1st 24 hrs. after shot Gas Cu. Ft.Dry Hole Abandoned

Date

JUN 1 2 1946 19S. J. LEWIS

Scout

KANSAS Kansas Pool Name McLouth Pool
 Map No. No Map Sec. 3 Twp. 10 R. 20E
 Well No. 9 Bankers Life

Miller Company

ABANDONED Contractor

NW/C

SECTION PLAT

330 Ft. from N. Line

 Ft. from S. Line

 Ft. from E. Line

330 Ft. from W. Line

0			

Leavenworth County

Location

Rig up

Drilling and Remarks:

Sand 1433

RECORD

Cased in., ft.

Sand

Gas

Oil

Total Depth 1430

PRODUCTION

1st 24 hrs. Nat.

1st 24 hrs. after shot

Gas Cu. Ft.

Dry Hole

Abandoned

Date

AUG 14 1946 19

S. J. LEWIS

Scout