


Section 3 Township 10 Range 20-E

Well No. #1 ~~Bankers Life~~ McCloud

Company Longwell et al
Miscellaneous

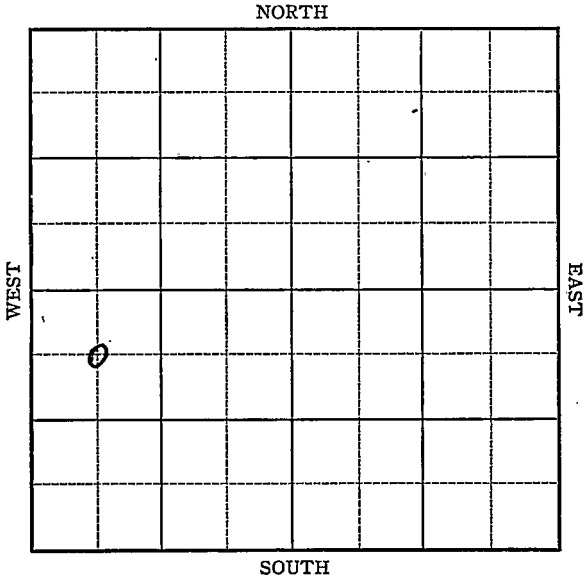

12

Sec. 3 Twp. 10 R. 20-E

Well No. #1 ~~Bankers Life~~ McCloud Farm

Longwell et al Company


(Misc.)

660 Ft. from N. Line

_____ Ft. from S. Line

_____ Ft. from E. Line

660 Ft. from W. Line

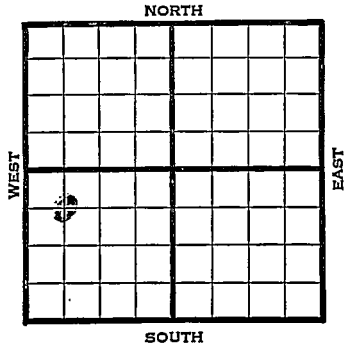

1941	REPORT
5/27	8" - 900'
	Drlg. 1391'
6/5	Drlg. 1410'
6/12	Bart. 1433' 5" - 1425'
	Shot 40 qts.
6/18	Bart. 1433'
	5" - 1425'
	T.D. 1441'
	Shot 40 qts.
	Pump 6 oil.
	28. Gravity
	COMPLETED

Map No. NM Sec. 3 Twp. 10 R. 20E

Well No. 1 McCloud

Longwell etal Company

Contractor

COMPLETED

SECTION PLAT

C NW SW

o			

660 Ft. from N. Line

_____ Ft. from S. Line

_____ Ft. from E. Line

660 Ft. from W. Line

MISCELLANEOUS

Location _____

Rig up _____

Drilling and Remarks:

Bar 81433
5" @ 1425.
Hog to.
Pump 6 Oil

280 SW

RECORD

Cased _____ in., _____ ft.

Sand _____

Gas _____

Oil _____

Total Depth 1441

PRODUCTION

1st 24 hrs. -Nat. _____

1st 24 hrs. after shot _____

Gas _____ Cu. Ft.

Dry Hole _____

Abandoned _____

Date

JUN 1 8 1941

S. J. LEWIS Scout

Map No. MM Sec. 3 Twp. 10 R. 20EWell No. 1 McCloudLongwell etal

Company

CORRECTION

Contractor

C NW SW

660 Ft. from N. Line

_____ Ft. from S. Line

_____ Ft. from E. Line

660 Ft. from W. Line

SECTION PLAT

0			

MISCELLANEOUS

Location _____

Rig up _____

Drilling and Remarks:

Reported as
Bankers Life.McCloud has bought
this farm.

RECORD

Cased _____ in., _____ ft.

Sand _____

Gas _____

Oil _____

Total Depth _____

PRODUCTION

1st 24 hrs. - Nat. _____

1st 24 hrs. after shot _____

Gas _____ Cu. Ft.

Dry Hole _____

Abandoned _____

Date

JUN 11 1941 19S. J. LEWIS Scout

Map No. NM Sec. 3 Twp. 10 R. 20E

Well No. 1 Bankers Life

Longwell etal Company

~~FIRST REPORT~~ Contractor

SECTION PLAT

C NW SW

660 Ft. from N. Line

_____ Ft. from S. Line

_____ Ft. from E. Line

660 Ft. from W. Line

MISCELLANEOUS

Location _____

Rig up _____

Drilling and Remarks:

8" - 900

Drlg. 1391

RECORD

Cased _____ in., _____ ft.

Sand _____

Gas _____

Oil _____

Total Depth _____

PRODUCTION

1st 24 hrs.-Nat. _____

1st 24 hrs. after shot _____

Gas _____ Cu. Ft.

Dry Hole _____

Abandoned _____

Date

MAY 27 1941 19

S. J. LEWIS Scout