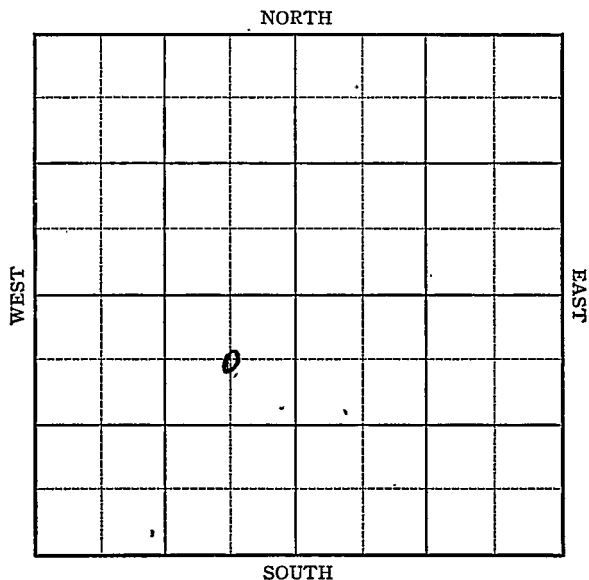


Section 3 Township 10 Range 20EWell No. 2 McLoudCompany Longwell et al

Map No. NM Sec. 3 Twp. 10 R. 20EWell No. 2 McLoudLongwell et al

Company

COMPLETED

Contractor

SECTION PLAT

660 C NE SW
Ft. from N. Line

Ft. from S. Line

660 Ft. from E. Line

Ft. from W. Line

MISCELLANEOUS

Location

Rig up

Drilling and Remarks:

*Bar 81377**5" @ 1379**709 to 1377-1420**Pump 60 P.S.**23 1/2 Gr.*

RECORD

Cased _____ in., _____ ft.

Sand _____

Gas _____

Oil _____

Total Depth 1420

PRODUCTION

1st 24 hrs. Nat. _____

1st 24 hrs. after shot _____

Gas _____ Cu. Ft.

Dry Hole _____

Abandoned _____

Date

JUL 23 1941

19

S. J. LEWIS

Scout