


KANSAS

Leavenworth county

Section 3 Township 10 Range 20-E

Well No. #10, Banker's Life

Company C. Miller

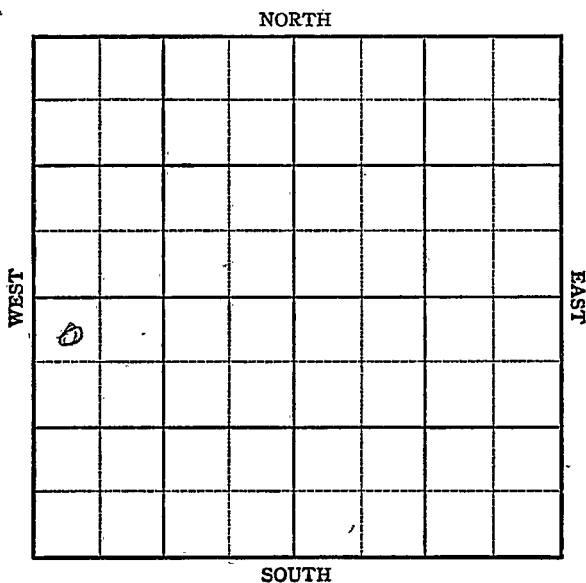

KANSAS

Leavenworth county

Sec. 3 Twp. 10 R. 20-E

Well No. #10, Banker's Life (TWIN) Farm

C. Miller Company


McLouth Pool

330' Ft. from N. Line

\_\_\_\_\_ Ft. from S. Line

\_\_\_\_\_ Ft. from E. Line

380' Ft. from W. Line

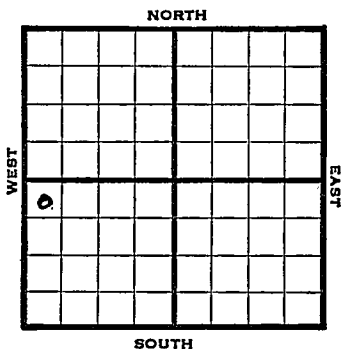

NW SW

1946

REPORT

12/18 Location

1947

1/4 Sand 1435 SO, SD

1/8 Sand 1435'  
TD 1480'

**ABANDONED**

Map No. No Map Sec. 3 Twp. 10 R. 20E

Well No. 10 Banker's Life

C. Miller Company

ABANDONED Contractor

NW SW

330 Ft. from N. Line

\_\_\_\_\_ Ft. from S. Line

\_\_\_\_\_ Ft. from E. Line

380 Ft. from W. Line

SECTION PLAT

o			

Leavenworth County

Location \_\_\_\_\_

Rig up \_\_\_\_\_

Drilling and Remarks:

*Sand 1435*

RECORD

Cased \_\_\_\_\_ in., \_\_\_\_\_ ft.

Sand \_\_\_\_\_

Gas \_\_\_\_\_

Oil \_\_\_\_\_

Total Depth 1480

PRODUCTION

1st 24 hrs. Nat. \_\_\_\_\_

1st 24 hrs. after shot \_\_\_\_\_

Gas \_\_\_\_\_ Cu. Ft.

Dry Hole \_\_\_\_\_

Abandoned \_\_\_\_\_

Date

JAN 8 1947 19

S. J. LEWIS Scout

Map No. No MAP Sec. 3 Twp. 10 R. 20E

Well No. 10 Banker's Life

C. Miller Company

**FIRST REPORT**

Contractor

NW SW

**SECTION PLAT**

330 Ft. from N. Line

\_\_\_\_\_ Ft. from S. Line

\_\_\_\_\_ Ft. from E. Line

380 Ft. from W. Line

o			

Leavenworth County

Location X

Rig up \_\_\_\_\_

Drilling and Remarks:

twin well

**RECORD**

Cased \_\_\_\_\_ in., \_\_\_\_\_ ft.

Sand \_\_\_\_\_

Gas \_\_\_\_\_

Oil \_\_\_\_\_

Total Depth \_\_\_\_\_

**PRODUCTION**

1st 24 hrs. Nat. \_\_\_\_\_

1st 24 hrs. after shot \_\_\_\_\_

Gas \_\_\_\_\_ Cu. Ft.

Dry Hole \_\_\_\_\_

Abandoned \_\_\_\_\_

Date

DEC 1 8 1946 19 \_\_\_\_\_

S. J. LEWIS Scout