

KANSAS

FORM 51 5M 4-41 PETROL

Leavenworth


~~Jefferson~~

Section 3 Township 10-S Range 20-E

Well No. #1 Steenstray

Company McLaughlin & Son


Wildcat

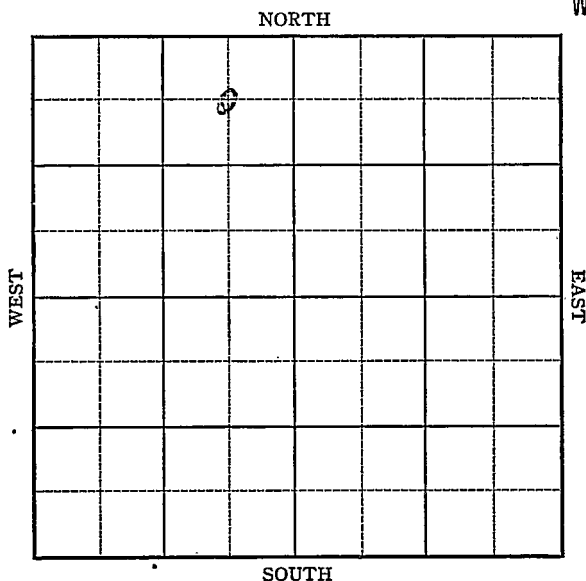

KANSAS

Leavenworth
JeffersonSec. 3 Twp. 10-S R. 20-EWell No. #1 Steenstry FarmMcLaughlin & Son Company

(Wildcat)

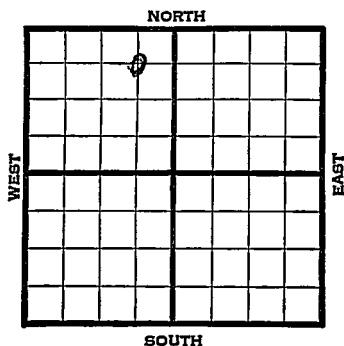660 Ft. from N. Line Ft. from S. Line660 Ft. from E. Line Ft. from W. Line

1941

REPORT

4/16

8" - 868'

Drlg. 1300'

4/24

SD 1300'

5/1

Bart. 1364' 6" - 1363'

T.D. 1429' 1/4 M gas.

5/7

Bart. 1364'.

6" - 1363'

T.D. 1429'

1 M. gas.

COMPLETED

Map No. NM Sec. 3 Twp. 10S R. 20EWell No. 1 SteenstryMcLaughlin & Son Company

Contractor

FIRST REPORT

C NE NW

660 Ft. from N. Line Ft. from S. Line660 Ft. from E. Line Ft. from W. Line

SECTION PLAT

WILDCAT

Location Rig up

Drilling and Remarks:

8" - 868

Drlg. 1300

RECORD

Cased in., ft.Sand Gas Oil Total Depth

PRODUCTION

1st 24 hrs. Nat. 1st 24 hrs. after shot Gas Cu. Ft.Dry Hole Abandoned

Date

APR 16 1941 19

S. J. LEWIS Scout

Map No. N 4 Sec. 3 Twp. 10 R. 20EWell No. 11 SteenstryMcLaughlin & Son CompanyCORRECTION Contractor

C NE NW

660 Ft. from N. Line Ft. from S. Line660 Ft. from E. Line Ft. from W. Line

SECTION PLAT

	o		

WILDCAT

Location Rig up

Drilling and Remarks:

Reported in

Jefferson County

RECORD

Cased in., ft.Sand Gas Oil Total Depth

PRODUCTION

1st 24 hrs. Nat. 1st 24 hrs. after shot Gas Cu. Ft.Dry Hole Abandoned

Date

APR 24 1941 19

S. J. LEWIS

Scout

KANSAS

Form 26—200 Bks.—1-40—Palace

LeavenworthMap No. NM Sec. 3 Twp. 10S R. 20EWell No. 1 SteenstryMcLaughlin & Son CompanyCOMPLETED Contractor**SECTION PLAT****C NE NW**660 Ft. from N. Line Ft. from S. Line660 Ft. from E. Line Ft. from W. Line

	o		

WILDCATLocation Rig up

Drilling and Remarks:

Bar 8 1364.6 " @ 13631M Gas**RECORD**Cased in., ft.Sand Gas Oil Total Depth 1429**PRODUCTION**1st 24 hrs. Nat. 1st 24 hrs. after shot Gas Cu. Ft.Dry Hole Abandoned

Date

MAY 7 1941 19S. J. LEWIS Scout