


Leavenworth

FORM 51 5M 4-41 PETROL

Section 3 Township 10 Range 20-E

Well No. #2 steenstry

Company McLaughlin et al

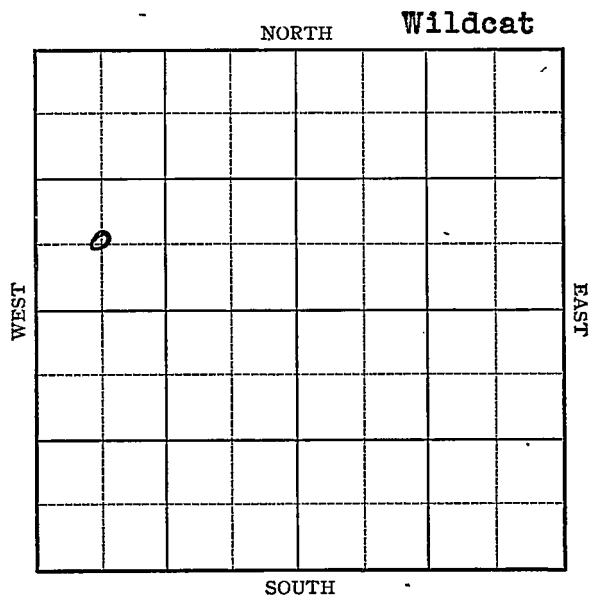

Sec. 3 Twp. 10 R. 20-E

Well No. #2 Steenstry Farm

McLaughlin et al Company


(Wild cat)

\_\_\_\_\_ Ft. from N. Line

660 Ft. from S. Line

\_\_\_\_\_ Ft. from E. Line

660 Ft. from W. Line

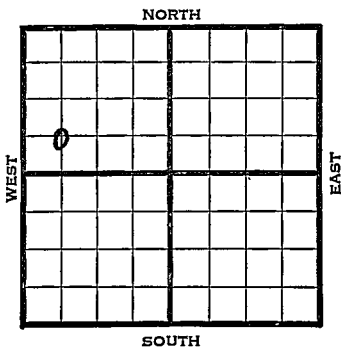

1941	REPORT
4/30	10" - 43' Drlg. 460'
5/8	8" - 874' Drlg. 1303'
5/14	Bart. 1363'
	6" - 1362'
	T.D. 1391'
	16,780,000 cu. ft. gas.
	<b>COMPLETED</b>

Map No. NM Sec. 3 Twp. 10 R. 20EWell No. 2 SteenstryMcLaughlin etal Company

Contractor

**FIRST REPORT****SECTION PLAT**

C SW NW

Ft. from N. Line

660 Ft. from S. Line

Ft. from E. Line

660 Ft. from W. Line

o			

WILDCAT

Location \_\_\_\_\_

Rig up \_\_\_\_\_

Drilling and Remarks:

10" - 43'

Drlg. 460

**RECORD**

Cased \_\_\_\_\_ in., \_\_\_\_\_ ft.

Sand \_\_\_\_\_

Gas \_\_\_\_\_

Oil \_\_\_\_\_

Total Depth \_\_\_\_\_

**PRODUCTION**

1st 24 hrs. Nat. \_\_\_\_\_

1st 24 hrs. after shot \_\_\_\_\_

Gas \_\_\_\_\_ Cu. Ft.

Dry Hole \_\_\_\_\_

Abandoned \_\_\_\_\_

Date

APR 30 1941 19

S. J. LEWIS Scout

# KANSAS

Form 26—200 Bks.—1-40—Palace

Leavenworth

Map No. NM Sec. 3 Twp. 10 R. 20EWell No. 2 SteenstryMcLaughlin etal CompanyCOMPLETE Contractor

## SECTION PLAT

C SW NW

o			

\_\_\_\_\_ Ft. from N. Line

660 Ft. from S. Line

\_\_\_\_\_ Ft. from E. Line

660 Ft. from W. Line

WIDCAT

Location \_\_\_\_\_

Rig up \_\_\_\_\_

Drilling and Remarks:

Bar 13636" @ 136216,780,000 cu ft. Gas

## RECORD

Cased \_\_\_\_\_ in., \_\_\_\_\_ ft.

Sand \_\_\_\_\_

Gas \_\_\_\_\_

Oil \_\_\_\_\_

Total Depth 1391

## PRODUCTION

1st 24 hrs. Nat. \_\_\_\_\_

1st 24 hrs. after shot \_\_\_\_\_

Gas \_\_\_\_\_ Cu. Ft.

Dry Hole \_\_\_\_\_

Abandoned \_\_\_\_\_

Date

MAY 14 1941S. J. LEWIS Scout