


Section 3 Township 10- Range 20-E

Well No. #6 Banker's Life Ins.

Company Chas. Miller

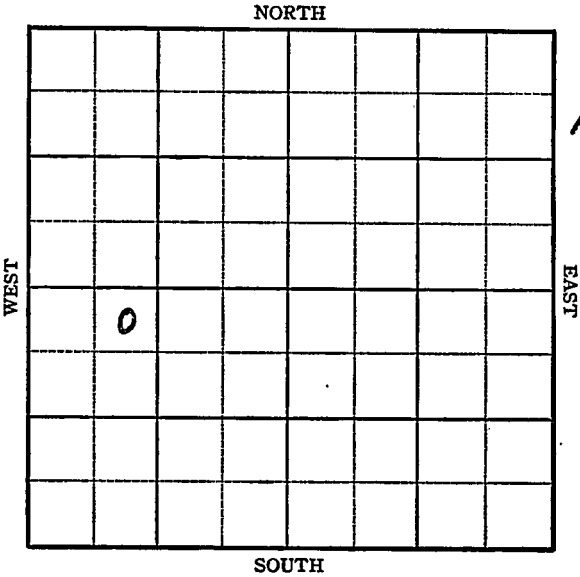

Sec. 3 Twp. 10 R. 20-E

Well No. #6 Banker's Life Ins. Farm

Chas Miller Company


330 Ft. from N. Line

\_\_\_\_\_ Ft. from S. Line

\_\_\_\_\_ Ft. from E. Line

990 Ft. from W. Line

NE NW SW

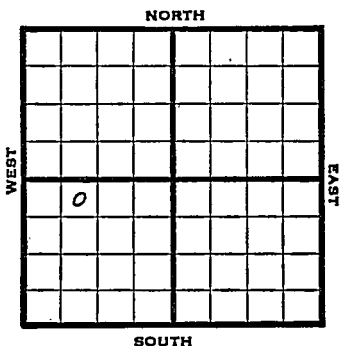

1945 Elev. 1086' REPORT

12/12 400' SD

12/20 "

12/29 "

1946

1/10 "

1/16 Sand 1427  
6" @ 1427  
TD 1472'  
Pump 40 Pot.  
Grav. 27.0

**COMPLETED**

**KANSAS**

Kansas Pool Name McLouth

Map No. Do Map Sec. 3 Twp. 10 R. 20E

Well No. 6 Banker's Life Ins.

Chas Miller

Company

**FIRST REPORT**

Contractor

NE NW SW

**SECTION PLAT**

330 Ft. from N. Line

\_\_\_\_\_ Ft. from S. Line

\_\_\_\_\_ Ft. from E. Line

990 Ft. from W. Line

o			

Leavenworth County

Location \_\_\_\_\_

Rig up \_\_\_\_\_

Drilling and Remarks:

400' BD

**RECORD**

Cased \_\_\_\_\_ in., \_\_\_\_\_ ft.

Sand \_\_\_\_\_

Gas \_\_\_\_\_

Oil \_\_\_\_\_

Total Depth \_\_\_\_\_

**PRODUCTION**

1st 24 hrs. Nat. \_\_\_\_\_

1st 24 hrs. after shot \_\_\_\_\_

Gas \_\_\_\_\_ Cu. Ft.

Dry Hole \_\_\_\_\_

Abandoned \_\_\_\_\_

Date

DEC 12 1945

19

S. J. LEWIS Scout

KANSAS

Kansas Pool Name McLouth

Map No. No map Sec. 3 Twp. 10 R. 20E

Well No. 6 Banker's Life Ins.

Chas Miller Company

**COMPLETED**

Contractor

NE NW SW

E11086  
SECTION PLAT

330 Ft. from N. Line

\_\_\_\_\_ Ft. from S. Line

\_\_\_\_\_ Ft. from E. Line

990 Ft. from W. Line


Leavenworth County

Location \_\_\_\_\_

Rig up \_\_\_\_\_

Drilling and Remarks:

*Sand 1427  
6" @ 1427  
Pump 40 ft*

*27 3/4*

**RECORD**

Cased \_\_\_\_\_ in., \_\_\_\_\_ ft.

Sand \_\_\_\_\_

Gas \_\_\_\_\_

Oil \_\_\_\_\_

Total Depth 1472

**PRODUCTION**

1st 24 hrs. Nat. \_\_\_\_\_

1st 24 hrs. after shot: \_\_\_\_\_

Gas \_\_\_\_\_ Cu. Ft.

Dry Hole \_\_\_\_\_

Abandoned \_\_\_\_\_

Date

JAN 16 1946 19

S. J. LEWIS

Scout