


Section 3 Township 10 Range 20-E

Well No. #8 Banker's Life

Company Chas. Miller

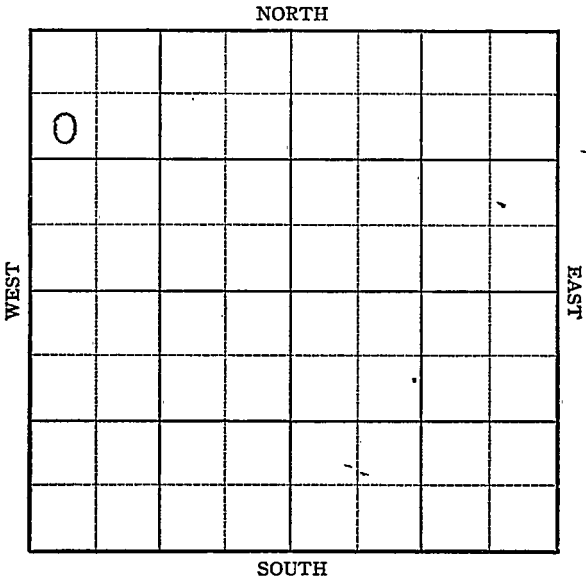

Sec. 3 Twp. 10 R. 20E

Well No. #8 Banker's Life Farm

Chas. Miller Company

McSouth


990 Ft. from N. Line

Ft. from S. Line

Ft. from E. Line

330 Ft. from W. Line

SW NWNW

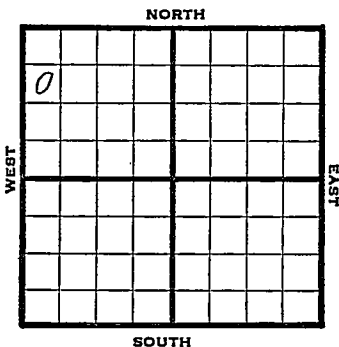

1946

REPORT

7/10 Location

7/16 "

7/23 "

7/30 "

8/6 "

8/14 Sand 1497  
TD 1501'

ABANDONED

**KANSAS**

Kansas Pool Name Mc South

Map No. 710 map Sec. 3 Twp. 10 R. 20E

Well No. 8 Banker's Life

Chas Miller Company

**FIRST REPORT** Contractor

SW NW NW

**SECTION PLAT**

990 Ft. from N. Line

\_\_\_\_\_ Ft. from S. Line

\_\_\_\_\_ Ft. from E. Line

330 Ft. from W. Line


Leavenworth County

Location X

Rig up \_\_\_\_\_

Drilling and Remarks:

**RECORD**

Cased \_\_\_\_\_ in., \_\_\_\_\_ ft.

Sand \_\_\_\_\_

Gas \_\_\_\_\_

Oil \_\_\_\_\_

Total Depth \_\_\_\_\_

**PRODUCTION**

1st 24 hrs. Nat. \_\_\_\_\_

1st 24 hrs. after shot \_\_\_\_\_

Gas \_\_\_\_\_ Cu. Ft.

Dry Hole \_\_\_\_\_

Abandoned \_\_\_\_\_

Date

JUL 10 1946

S. J. LEWIS Scout

**KANSAS** Kansas Pool Name McLouth Pool

Map No. NA 1113 Sec. 3 Twp. 10 R. 20E

Well No. 8 Bankers Life

Chas. Miller Company

**ABANDONED** Contractor

SW NW NW

**SECTION PLAT**

990 Ft. from N. Line

\_\_\_\_\_ Ft. from S. Line

\_\_\_\_\_ Ft. from E. Line

330 Ft. from W. Line

0			

Leavenworth County

Location \_\_\_\_\_

Rig up \_\_\_\_\_

Drilling and Remarks:

*Sand 149'*

**RECORD**

Cased \_\_\_\_\_ in., \_\_\_\_\_ ft.

Sand \_\_\_\_\_

Gas \_\_\_\_\_

Oil \_\_\_\_\_

Total Depth 1501

**PRODUCTION**

1st 24 hrs. Nat. \_\_\_\_\_

1st 24 hrs. after shot \_\_\_\_\_

Gas \_\_\_\_\_ Cu. Ft.

Dry Hole \_\_\_\_\_

Abandoned \_\_\_\_\_

Date

AUG 14 1946 19

S. J. LEWIS

Scout