


Section 3 Township 10 Range 20E

Well No. 5 Bankers Life

Company C. E. Miller

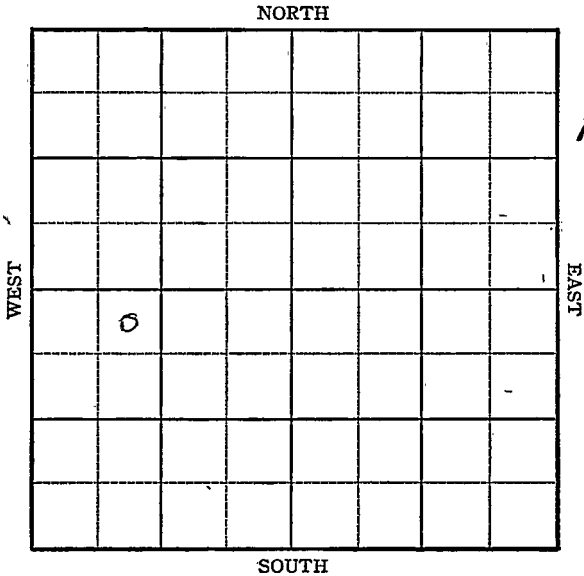

12

KANSAS Leavenworth

Sec. 3 Twp. 10 R. 20-E

Well No. #5 Bankers Life Farm


C. E. Miller Company

330 Ft. from N. Line

_____ Ft. from S. Line

_____ Ft. from E. Line

990 Ft. from W. Line

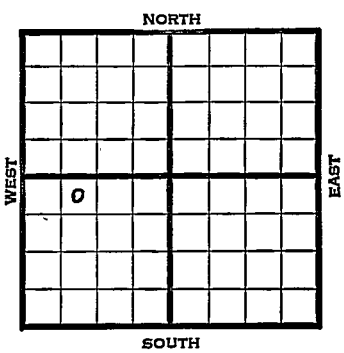

NE NW SW

1945

R E P O R T

8/22 10" @ 18'
Drlg. 660'

8/29 Drlg. 855

9/5 8" @ 901
Drlg. 1060

9/12 " "

9/19 Sd. 1427
6" @ 1427
B Sd. 146
TD 1472
500' oil 12 hrs.

9/26 " " "

10/3 " " "

10/10 " " "

10/17 Sand 1427
6" @ 1427
TD 1472
Pump 40 Pot.
Grav. 27.0

COMPLETED

Pool Name McLouth

Map No. 20 ^{Kansas} ~~Map~~ **KANSAS** Sec. 3 Twp. 10 R. 20E

Well No. 5 Bankers Life

G. E. Miller Company

FIRST REPORT

Contractor

NE NW SW

SECTION FLAT

330 Ft. from N. Line

_____ Ft. from S. Line

_____ Ft. from E. Line

990 Ft. from W. Line

o			

Leavenworth County

RECORD

Location _____

Cased _____ in., _____ ft.

Rig up _____

Sand _____

Drilling and Remarks:

Gas _____

10" - 18'

Oil _____

660

Total Depth _____

PRODUCTION

1st 24 hrs. Nat. _____

1st 24 hrs. after shot _____

Gas _____ Cu. Ft.

Dry Hole _____

Abandoned _____

Date

AUG 22 1945

19

S. J. LEWIS

Scout

KANSAS

Kansas

Pool Name Fairmont

Map No. no map Sec. 3 Twp. 10 R. 20E

Well No. 5 Bankers Life

C. E. Miller Company

COMPLETED

Contractor

NE NW SW

SECTION PLAT

330 Ft. from N. Line

_____ Ft. from S. Line

_____ Ft. from E. Line

990 Ft. from W. Line

o			

Leavenworth

Location _____

Rig up _____

Drilling and Remarks:

*Sand 1427
6" @ 1427
Pump 40 Pk*

27° E

RECORD

Cased _____ in., _____ ft.

Sand _____

Gas _____

Oil _____

Total Depth 1472

PRODUCTION

1st 24 hrs. Nat. _____

1st 24 hrs. after shot _____

Gas _____ Cu. Ft.

Dry Hole _____

Abandoned _____

Date

OCT 17 1945

19

S. J. LEWIS

Scout