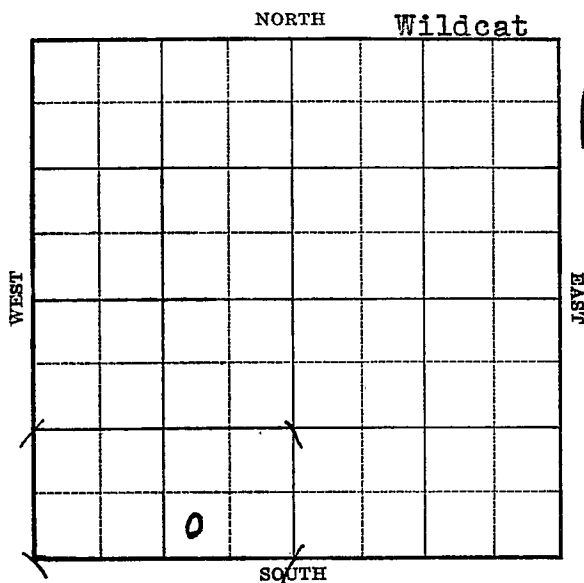


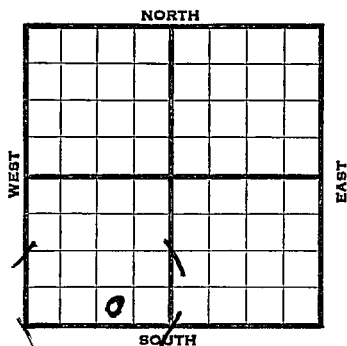
Section 30 Township 10 Range 22-EWell No. 1 ShellerCompany John Hardaway

KANSAS

Leavenworth

Sec. 30 Twp. 10 R. 22-EWell No. #1 Sheller FarmJohn Hardaway Company

(Wildcat)

       Ft. from N. Line330 Ft. from S. Line990 Ft. from E. Line       Ft. from W. Line

| 1939 | REPORT                 |                |
|------|------------------------|----------------|
| 2/1  | 10" - 44'. Mach.       |                |
|      | Drlg. 225'.            |                |
| 2/10 | S. G. 327'. Drlg. 337. |                |
| 2/17 | SD 345                 | 6/29 SD 390'   |
| 2/23 | "                      | 7/6 "          |
| 3/3  | "                      | 7/13 "         |
| 3/10 | "                      | 7/20 "         |
| 3/17 | "                      |                |
| 3/24 | "                      | 7/26 T.D. 390' |
| 3/31 | "                      | ABANDONED      |
| 4/7  | "                      |                |
| 4/14 | "                      |                |
| 4/21 | "                      |                |
| 4/28 | "                      |                |
| 5/5  | "                      |                |
| 5/12 | "                      |                |
| 5/19 | SD 390'                |                |
| 5/26 | "                      |                |
| 6/1  | "                      |                |
| 6/8  | "                      |                |
| 6/16 | "                      |                |
| 6/23 | "                      |                |

Leavenworth **KANSAS**Map No. WM Sec. 30 Twp. 10 R. 22EWell No. 1 Shell erJohn Hardaway

Company

Contractor

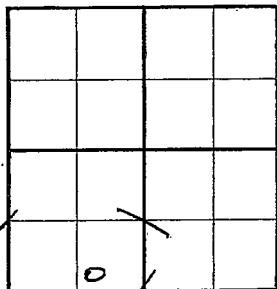
**FIRST REPORT**

SW SE SW

Ft. from N. Line

330 Ft. from S. Line990 Ft. from E. Line

Ft. from W. Line

**WILDCAT****SECTION PLAT**

Location \_\_\_\_\_

Rig up \_\_\_\_\_

Drilling and Remarks: \_\_\_\_\_

Mach. \_\_\_\_\_

10" - 44Dr 1g. 225**RECORD**

Cased \_\_\_\_\_ in., \_\_\_\_\_ ft.

Sand \_\_\_\_\_

Gas \_\_\_\_\_

Oil \_\_\_\_\_

Total Depth \_\_\_\_\_

**PRODUCTION**

1st, 24 hrs. Nat. \_\_\_\_\_

1st, 24 hrs. after shot \_\_\_\_\_

Gas \_\_\_\_\_ Cu. Ft.

Dry Hole \_\_\_\_\_

Abandoned \_\_\_\_\_

Date

FEB 1 - 1939 19 H. D. Hatfield Scout

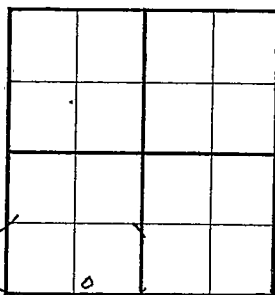
Map No. NM Sec. 30 Twp. 10 R. 22EWell No. 1 ShellerJohn Hardaway

Company

Contractor

ABANDONED  
SW SE SW

SECTION PLAT

       Ft. from N. Line330 Ft. from S. Line990 Ft. from E. Line       Ft. from W. Line

WILDCAT

Location                                 Rig up                                 

Drilling and Remarks:

## RECORD

Cased            in.,            ft.Sand                                 Gas                                 Oil                                 Total Depth 280

## PRODUCTION

1st 24 hrs. Nat.                                 1st 24 hrs. after shot                                 Gas                                  Cu. Ft.Dry Hole                                 Abandoned                                 

Date

JUL 26 1939 19

S. J. LEWIS

Scout