

15 103 00005 0000

KANSAS


FORM 51 5M BRX

Leavenworth

Section 31 Township 10 Range 22E

Well No. #1 Lewis Sifert

Company Dan McLaughlin

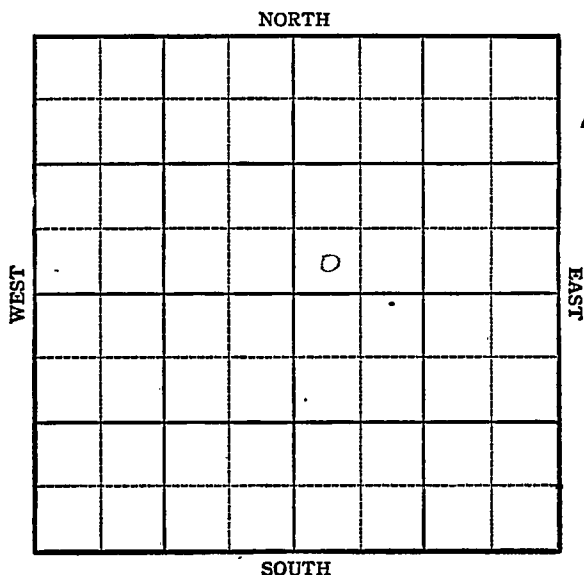

Sec. 31 Twp. 10 R. 22E

Well No. #1 Lewis Siefert Farm

Dan McLaughlin Company

McLouth

NORTH

 Ft. from N. Line

330 Ft. from S. Line

 Ft. from E. Line

330 Ft. from W. Line

WEST

EAST

SOUTH

SW NE

REPORT

1944

8/16 Loc.

8/23 "

8/30 Drlg. 300'

9/8 " "

9/13 " "

9/21 Drlg. 1115

9/28 " "

10/4 Miss. 1136

6" @ 1079

TD 1276

ABANDONED

Pool Name McLouthMap No. NM Sec. 31 Twp. 10 R. 22EWell No. 1 Lewis SeufertDan McLaughlin

Company

ABANDONED

Contractor

SW ^{NE}

SECTION PLAT

 Ft. from N. Line330 Ft. from S. Line Ft. from E. Line330 Ft. from W. LineLeavenworth CountyLocation Rig up

Drilling and Remarks:

Miss 11366" @ 1079

RECORD

Cased in, ft.Sand Gas Oil Total Depth 1276

PRODUCTION

1st 24 hrs. Nat. 1st 24 hrs. after shot Gas Cu. Ft.Dry Hole Abandoned

Date

OCT 4 194419S. J. LEWISScout

Pool Name McLouthMap No. KANSAS Sec. 31 Twp. 10 R. 22EWell No. 1 Lewis SiefertDan McLaughlin Company

FIRST REPORT

Contractor

SW NE

SECTION PLAT

 Ft. from N. Line330 Ft. from S. Line Ft. from E. Line330 Ft. from W. LineLeavenworthLocation XRig up

Drilling and Remarks:

RECORD

Cased in., ft.Sand Gas Oil Total Depth

PRODUCTION

1st 24 hrs. Nat. 1st 24 hrs. after shot Gas Cu. Ft.Dry Hole Abandoned

Date

AUG 16 1944 19S. J. LEWIS

Scout