

Leavenworth

FORM 252A-5M-8-30-PETROL

Map No. **KANSAS** Sec. 32 Twp. 10 R. 2/E

Well No. 1-Forb Farm

West et al Company


660 Ft. from N. Line

_____ Ft. from S. Line

_____ Ft. from E. Line

660 Ft. from W. Line

1932

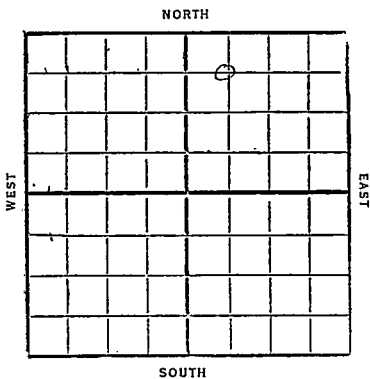

Date	REPORT
8/10	Drel 575'
8/17	No report
8/24	Drel 680'
8/31	SID 680'
9/7	—
9/14	TD 900' fishing
9/21	TD 928' DIR 6"
9/30	—
10/5	—
10/12	SID 10.00'
10/19	—
10/26	Cased 6"-990 Sand 985-1035 dry " 1271-86' HFW Top lime 1286 TD 1288 dry & Abandon

Map No. **KANSAS** Sec. *32* Twp. *10* R. *21* ^E

Well No. *1* *Kerk*

West of Company

1 Contractor

COMPLETED

660 Ft. from N. Line

..... Ft. from S. Line

..... Ft. from E. Line

660 Ft. from W. Line

SECTION PLAT

		0	

ABANDONED

Location.....

Rig up.....

Drilling and Remarks:

Land 985-1035 Dry
1/2 1271-86 HFW
Top line 1286

RECORD

Cased *6* in., *990* ft.

Sand.....

Gas.....

Oil.....

Total Depth *1288*

PRODUCTION

1st 24 hrs. Nat.....

1st 24 hrs. after shot.....

Gas..... Cu. Ft.

Dry Hole..... ✓

Abandoned..... ✓

Date

OCT 26 1932

CHAS. L. SHERWOOD

Scout

Neenah North

KANSAS

E

Map No. _____ Sec. *32* Twp. *10* R. *21*

Well No. *1 Herb*

West of al _____ Company

Contractor

FIRST REPORTS

660 Ft. from N. Line

_____ Ft. from S. Line

_____ Ft. from E. Line

660 Ft. from W. Line

SECTION PLAT

		a	

Location _____

Rig up _____

Drilling and Remarks:

Log 575

RECORD

Cased _____ in., _____ ft.

Sand _____

Gas _____

Oil _____

Total Depth _____

PRODUCTION

1st 24 hrs. Nat. _____

1st 24 hrs. after shot _____

Gas _____ Cu. Ft.

Dry Hole _____

Abandoned _____

Date

AUG 10 1932

CHAS. L. SHERWOOD

192

Scout