

KANSAS

FORM 51 5M 10-41 PETROL

Jefferson

Section 4 Township 10 Range 20-E

Well No. #1 McLaughlin

Company Billingsley etal.

McLouth Pool

NORTH

	0						

WEST

EAST

SOUTH


5

KANSAS

Jefferson

Sec. 4 Twp. 10 R. 20-EWell No. #1 McLaughlin FarmBillingsley et al Company
(McLouth Pool) Ft. from N. Line990 Ft. from S. Line Ft. from E. Line990 Ft. from W. Line

Elev. 1091

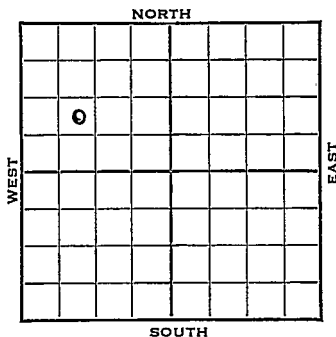

1942

REPORT

9/2 80' spud Oil test.

9/16 Bart 1440 fsg.

9/23 Miss 1447 T.D. 1530
6" 1450' SW & 4 Bbls oil per hour

9/30 Bartlsv. 1440

McLouth 1404

6-5/8" 1450

Pay 1588-1601

TD 1601

Pot. pump 50 bopd

24 grav.

COMPLETED

Map No. MM Sec. 4 Twp. 10 R. 20EWell No. 1 McLaughlinBillingsley et al. Company**FIRST REPORT**

Contractor

NE SW NW

SECTION PLAT

o			

 Ft. from N. Line990 Ft. from S. Line Ft. from E. Line990 Ft. from W. Line

MCLOUTH POOL

Location Rig up

Drilling and Remarks:

80' Spud

Oil test

RECORD

Cased in., ft.Sand Gas Oil Total Depth

PRODUCTION

1st 24 hrs. Nat. 1st 24 hrs. after shot Gas Cu. Ft.Dry Hole Abandoned

Date

SEP 2 1942 19

S. J. LEWIS Scout

Misc. Small Maps	X
Cards	<i>Qua</i>
Tracing	
France Map	
Scarborough Map	X
Moody Map	
Geological Dept.	
Moody Flat Book	

Jefferson

KANSAS

Map No. MM Sec. 4 Twp. 10 R. 20EWell No. 1 McLaughlinBillingsley etal. Company

Contractor

NE SW NW

SECTION PLAT

 Ft. from N. Line990 Ft. from S. Line Ft. from E. Line990 Ft. from W. Line

1			

MCLOUTH POOL

Location Rig up

Drilling and Remarks:

Pay 1588-1601

Pot. Pump
50 Bopd
24 Gravity

RECORD

Cased 6 5/8 in., 1450 ft.Sand Gas Oil Total Depth 1601

PRODUCTION

1st 24 hrs. Nat. 1st 24 hrs. after shot Gas Cu. Ft.Dry Hole Abandoned

Date

COMPLETED

SEP 30 1942 19

S. J. LEWIS Scout

Bart/|sv. 1440
McLouth 1404

