

KANSAS

FORM 51 5M 10-41 PETROL

Section 4 Township 10 Range 20E

Well No. 2 McLaughlin

Company Billingsley et al.
McClouth pool

NORTH

WEST

EAST

SOUTH

4

KANSAS Jefferson

Sec. 4 Twp. 10 R. 20-E

Well No. #2 McLaughlin Farm

Billingsley et al Company

(McLouth Pool)

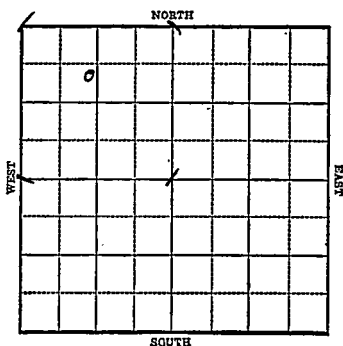
745 Ft. from N. Line

 Ft. from S. Line

 Ft. from E. Line

1100 Ft. from W. Line

C EL NW NW



1942

R E P O R T

10/14

10" - 151'
Drlg. 170'

10/21

8" @ 877 Drlg 933'

11/4

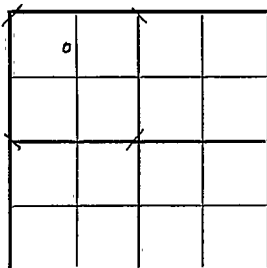
Miss 1448'
6" @ 1451 HFW TD 1607'

ABANDONED

Map No. MM Sec. 4 Twp. 10 R. 20EWell No. 2 McLaughlinBillingsley etal. CompanyFIRST REPORT Contractor

C EL NW NW

SECTION PLAT

745 Ft. from N. Line Ft. from S. Line Ft. from E. Line1100 Ft. from W. Line

MCLOUTH POOL

Location Rig up

Drilling and Remarks:

10" - 151'Dr1g. 170'

RECORD

Cased in., ft.Sand Gas Oil Total Depth

PRODUCTION.

1st 24 hrs. Nat. 1st 24 hrs. after shot Gas Cu. Ft.Dry Hole Abandoned

Date

OCT 14 1942 19S. J. LEWIS Scout

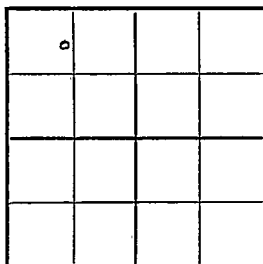
Misc. Small Maps	X
Cards	<i>Om</i>
Tracing	
France Map	
Scarborough Map	X
Moody Map	
Geological Dept.	
Moody Plat Book	

Jefferson

Map No. YM Sec. 4 Twp. 10 R. 20EWell No. 2 McLaughlinBillingsley etal. CompanyABANDONED Contractor

C EL NW NW

SECTION PLAT

745 Ft. from N. Line Ft. from S. Line Ft. from E. Line1100 Ft. from W. Line

MCLOUTH POOL

Location Rig up Drilling and Remarks: Miss 14486" @ 1457H.F.W.

RECORD

Cased in., ft.Sand Gas Oil Total Depth 1607

PRODUCTION

1st 24 hrs. Nat. 1st 24 hrs. after shot Gas Cu. Ft.Dry Hole Abandoned

Date

NOV 4 1942 19S. J. LEWIS Scout

no wall map

Misc Small Maps	<i>No small map on</i>
Cards	<i>S.H.</i>
Tracing	
France Map	
Scarborough Map	<i>X</i>
Moody Map	
Geological Dept.	
Moody Flat Book	