

Jefferson

FORM 51 5M 4-41 PETROL

15 087 00040 0000

Section 4 Township 10 Range 20-E

Well No. #2 McLaughlin

Company McLaughlin

NORTH Miscellaneous

WEST

EAST

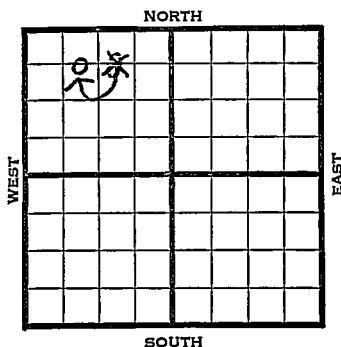
SOUTH

KANSAS

Jefferson

Sec. 4 Twp. 10 R. 20-EWell No. #2 McLaughlin FarmMcLaughlin Company

(Misc.)

660 Ft. from N. Line Ft. from S. Line~~990~~ Ft. from E. Line990 Ft. from W. Line

1941

REPORT

5/27

Location

6/5

"

6/12

10" - 30' Drlg. 400'

6/19

8" - 825' Bart. 1410 $\frac{1}{2}$ '

6/26

4,200,000 gas.

7/1

Bart. 1410 $\frac{1}{2}$ '6" - 1410 $\frac{1}{2}$ '

T.D. 1448'

4,200,000 cu. ft. gas.

COMPLETED

Map No. NM Sec. 4 Twp. 10 R. 20EWell No. 2 McLaughlinMcLaughlin CompanyFIRST REPORT Contractor

C W L NE NW

SECTION PLAT

	0		

660 Ft. from N. Line Ft. from S. Line990 Ft. from E. Line Ft. from W. Line

MISCELLANEOUS

Location XRig up

Drilling and Remarks:

RECORD

Cased in., ft.Sand Gas Oil Total Depth

PRODUCTION

1st 24 hrs. Nat. 1st 24 hrs. after shot Gas Cu. Ft.Dry Hole Abandoned

Date

MAY 27 1941

19

S. J. LEWIS Scout

Map No. NM Sec. 4 Twp. 10 R. 20EWell No. 2 McLaughlinMcLaughlin

Company

CORRECTION

Contractor

C E L NW NW

660 Ft. from N. Line Ft. from S. Line Ft. from E. Line990 Ft. from W. Line

MISCELLANEOUS

SECTION PLAT

o			

Location Rig up

Drilling and Remarks:

Reported

C W L NE NW

RECORD

Cased in., ft.Sand Gas Oil Total Depth

PRODUCTION

1st 24 hrs. -Nat. 1st 24 hrs. after shot Gas Cu. Ft.Dry Hole Abandoned

Date

JUN 1 1 1941 19S. J. LEWIS Scout

Map No. NM Sec. 4 Twp. 10 R. 20EWell No. 2 McLaughlinMcLaughlin CompanyCOMPLETED Contractor

C E L NW NW

SECTION PLAT

0			

660 Ft. from N. Line Ft. from S. Line Ft. from E. Line990 Ft. from W. Line

MISCELLANEOUS

Location Rig up

Drilling and Remarks:

Bar 1410 1/26" @ 1410 1/24,200,000 cu ft. Gas

RECORD

Cased in., ft.Sand Gas Oil Total Depth 1448

PRODUCTION

1st 24 hrs. Nat. 1st 24 hrs. after shot Gas Cu. Ft.Dry Hole Abandoned

Date

JUL 1 1941 19 S. J. LEWIS Scout