


Map No. **KANSAS** Sec. **4** Twp. **10** R. **4E**
 Well No. **J Myers** Farm
Seever et al Company

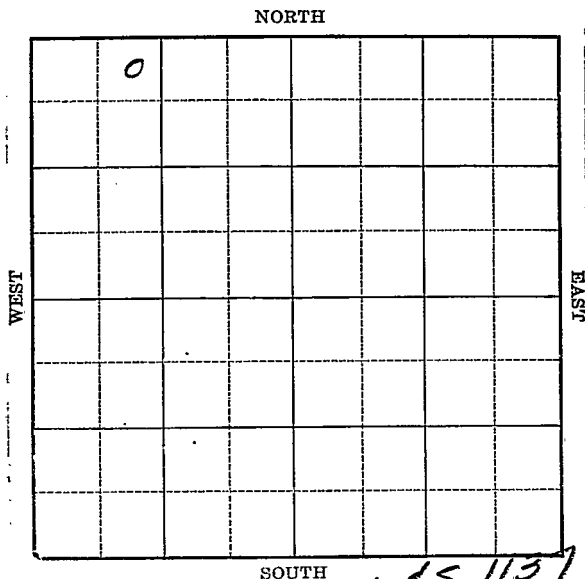

Location _____

Drilling Remarks _____

RECORD

Cased _____ in. _____ ft.

Sand _____

Gas _____

Oil _____

Total Depth _____

Rig Up _____

Drilling Remarks _____

PRODUCTION

1st 24 hrs. Nat. _____

1st 24 hrs. after shot _____

Gas _____ cu. ft. _____

Dry Hole _____


Abandoned _____

Clay

Map No. KANSAS Sec. 4 Twp. 10 R. 4EWell No. 1 Myers Farm
Severs et al Company330 Ft. from N. Line

Ft. from S. Line

Ft. from E. Line

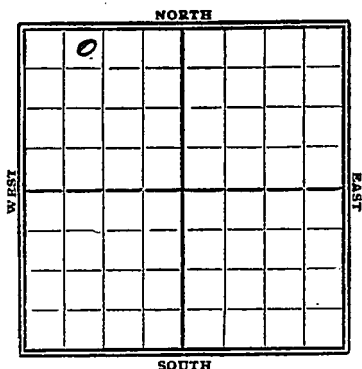990 Ft. from W. Line

Date	REPORT
4/25	Machine dely 541
5/3	dely 590
5/10	" 685
5/18	SD 700
5/25	--- 5/31 --- 6/7 --- 6/14 ---
6/21	dely 1180 10" 715
6/28	" 1860
7/5	Correct. 8" 1182 C.O.
7/12	Log 1395
7/19	dely 1445
7/26	---
8/2	SD 1535
8/9	SD 1555
8/16	--- 8/23 ---
8/30	dely 1635
9/6	dely u.R. logs
9/13	" 1667 5" 1661
9/19	" 1710
9/27	" 1790
10/4	1796 SD
10/11	T Miss 1775 Log 1834
10/18	--- 10/25 --- 11/1 --- 11/8 --- 11/15 ---
	- OVER -

11/22 T Miss 1775 fog 1834
11/28 — 12/6 — 12/13 —
12/21 — 12/27 — 1/3/35 —
1/10 — 1/17 — 1/24 — 1/31 —
2/7 — 2/14 — 2/21 — 2/28 —
3/7 SD 1834
3/14 — 3/21 — 3/28 — 4/4 —
4/11 — 4/18 — 4/26 — 5/2 —
5/8 abd 1834.

ABANDONED

KANSAS

Map No. 102 Sec. 4 Twp. 10 R. 4EWell No. 1-MyersBeavers et al Company

Contractor

~~INTEREST~~
REPORTS

SECTION PLAT

0			

330 Ft. from N. Line

_____ Ft. from S. Line

_____ Ft. from E. Line

990 Ft. from ~~W.~~ Line

Location _____

Rig up _____

Drilling and Remarks:

Machine
Blg 541

RECORD

Cased _____ in., _____ ft.

Sand _____

Gas _____

Oil _____

Total Depth _____

PRODUCTION

1st 24 hrs. Nat. _____

1st 24 hrs. after shot _____

Gas _____ Cu. Ft.

Dry Hole _____

Abandoned _____

Date

4-25-34 19

ORVAL MANNSCHRECK

Scout

no sun all
no wall

Returned	
Cards	RPF
Tracing	COCK
France Map	X
Scarborough Map	X
Moody Map	X
Scarborough PL. Book	
Moody F's Book	

Map No. 102 Sec. 4 Twp. 10 R. 4EWell No. 1-MyersSevens Ltd Company

Contractor

ABANDONED

SECTION PLAT

0			

330 Ft. from N. Line

Ft. from S. Line

Ft. from E. Line

990 Ft. from W. Line

Location

Rig up

Drilling and Remarks:

RECORD

Cased in, ft.

Sand

Gas

Oil

Total Depth 1834

PRODUCTION

1st 24 hrs. Nat.

1st 24 hrs. after shot

Gas Cu. Ft.

Dry Hole

Abandoned

Date

5-8-35 192 ORVAL MANNSCHRECK Scout

no small
no wall

Reclama

Cards

Tracing

Francis Whap





Handwritten initials

Handwritten initials

Handwritten X

Handwritten X

Handwritten X

Handwritten initials

Handwritten initials