

KANSAS Jefferson


FORM 51 5M 4-41 PETROL

Section 4 Township 10 Range 20-E

Well No. #1 Bankers Life McLeod

Company A & B Pipeline

(Misc.)

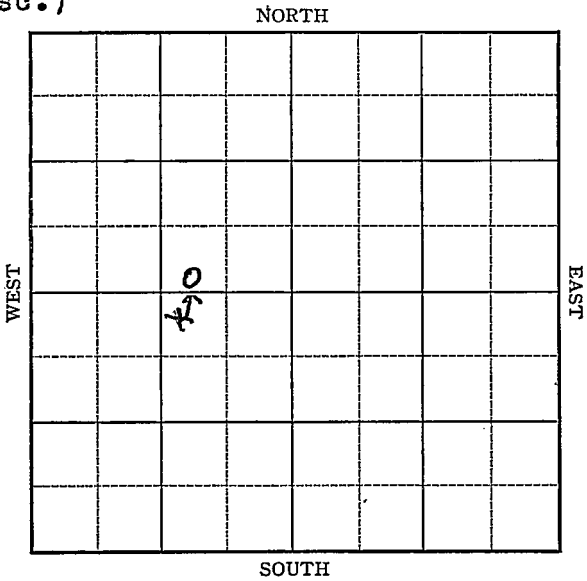



**KANSAS**Map No. NM Sec. 4 Twp. 10 R. 20EWell No. 1 Bankers LifeA & B Pipeline

Company

**FIRST REPORT**

Contractor

## SECTION PLAT

NW NE SW

330 Ft. from N. Line

\_\_\_\_\_ Ft. from S. Line

990 Ft. from E. Line

\_\_\_\_\_ Ft. from W. Line

	0		

## MISCELLANEOUS

Location \_\_\_\_\_

Rig up \_\_\_\_\_

Drilling and Remarks:

Machine Spud

## RECORD

Cased \_\_\_\_\_ in., \_\_\_\_\_ ft.

Sand \_\_\_\_\_

Gas \_\_\_\_\_

Oil \_\_\_\_\_

Total Depth \_\_\_\_\_

## f. PRODUCTION

1st 24 hrs. Nat. \_\_\_\_\_

1st 24 hrs. after shot \_\_\_\_\_

Gas \_\_\_\_\_ Cu. Ft.

Dry Hole \_\_\_\_\_

Abandoned \_\_\_\_\_

Date

AUG 6 1941S. J. LEWIS Scout

Map No. MM Sec. 4 Twp. 10 R. 20EWell No. 1 McLeodA. & B. Pipe line Company

Correction \_\_\_\_\_ Contractor

SW SE NW

## SECTION PLAT

\_\_\_\_\_ Ft. from N. Line

100 Ft. from S. Line990 Ft. from E. Line

\_\_\_\_\_ Ft. from W. Line

MISCELLANEOUS


Location \_\_\_\_\_

Rig up \_\_\_\_\_

Drilling and Remarks:

Reported

NW NE SW

## RECORD

Cased \_\_\_\_\_ in., \_\_\_\_\_ ft.

Sand \_\_\_\_\_

Gas \_\_\_\_\_

Oil \_\_\_\_\_

Total Depth \_\_\_\_\_

## PRODUCTION

1st 24 hrs. Nat. \_\_\_\_\_

1st 24 hrs. after shot \_\_\_\_\_

Gas \_\_\_\_\_ Cu. Ft.

Dry Hole \_\_\_\_\_

Abandoned \_\_\_\_\_

Date

AUG 20 1941 19S. J. LEWIS Scout

