

KANSAS


Jefferson

FORM 51 5M 1-42 PETROL

Section 4 Township 10 Range 20-E

Well No. #2 McLaughlin

Company Mosley & Adams

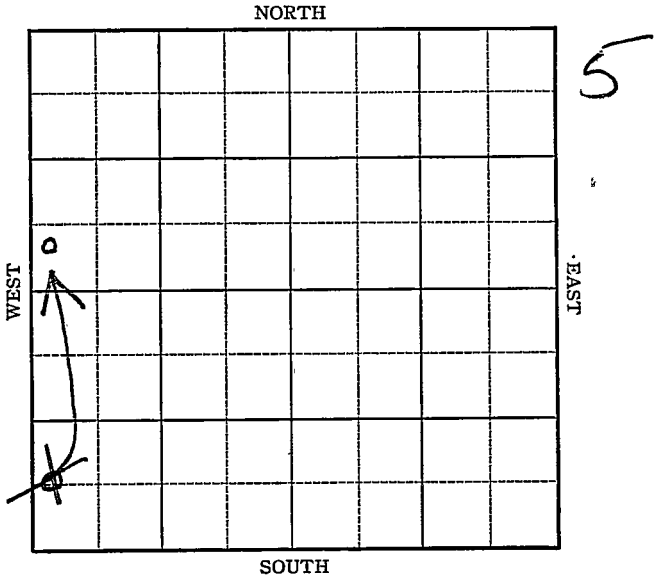

Sec. 4 Twp. 10 R. 20-E

Well No. #2 McLaughlin Farm

Mesley & Adams Apperson et al Company


McLouth

_____ Ft. from N. Line

520 Ft. from S. Line

_____ Ft. from E. Line

390 Ft. from W. Line

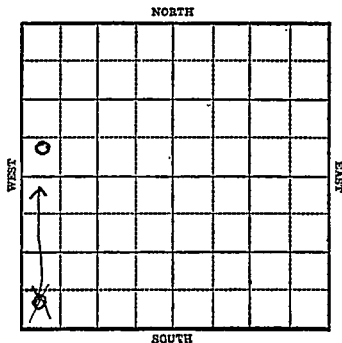

1943

R E P O R T

3/24 10" Casing set 38'
Dgle. 105'

3/31 Drlg. 420

4/7 8" @ 870'
Drlg. 918'

4/14 6" @ 1535'
Drlg. 1581'

4/21 and 1390

Miss 1425
T.D. 1581 SOL

4/28 Miss. 1425
6" @ 1535'
T.D. 1581'
2000 gal. acid
Pump 30 Pot.
Gravity 26

COMPLETED

Jefferson

KANSAS

Map No. MM Sec. 4 Twp. 10 R. 20E

Well No. 2 McLaughlin

Apperson et al. Company

CORRECTION Contractor

C WL SW NW

SECTION PLAT

_____ Ft. from N. Line

520 Ft. from S. Line

_____ Ft. from E. Line

390 Ft. from W. Line

0			

MCLOUTH POOL

Location _____

Rig up _____

Drilling and Remarks:

Reported as
Mosley & Adams
in SW Quarter

RECORD

Cased _____ in., _____ ft.

Sand _____

Gas _____

Oil _____

Total Depth _____

PRODUCTION

1st 24 hrs. Nat. _____

1st 24 hrs. after shot _____

Gas _____ Cu. Ft.

Dry Hole _____

Abandoned _____

Date

APR 2 1943 19

S. J. LEWIS Scout

KANSAS

Map No. N/M Sec. 4 Twp. 10 R. 20E

Well No. 2 McLaughlin

Mosley & Adams Company

FIRST REPORT Contractor

C WL SW SW

SECTION PLAT

_____ Ft. from N. Line

520 Ft. from S. Line

_____ Ft. from E. Line

390 Ft. from W. Line

MCLOUTH POOL

Location _____

Rig up _____

Drilling and Remarks:

10"-38'

Drlg. 105'

RECORD

Cased _____ in., _____ ft.

Sand _____

Gas _____

Oil _____

Total Depth _____

PRODUCTION

1st 24 hrs. Nat. _____

1st 24 hrs. after shot _____

Gas _____ Cu. Ft.

Dry Hole _____

Abandoned _____

Date _____

MAR 24 1943 19

S. I LEWIS Scout