

KANSAS


FORM 51 5M 1-42 PETROL

Leavenworth

Section 5 Township 10 Range 21-E

Well No. #3 Farrar

Company McLaughlin

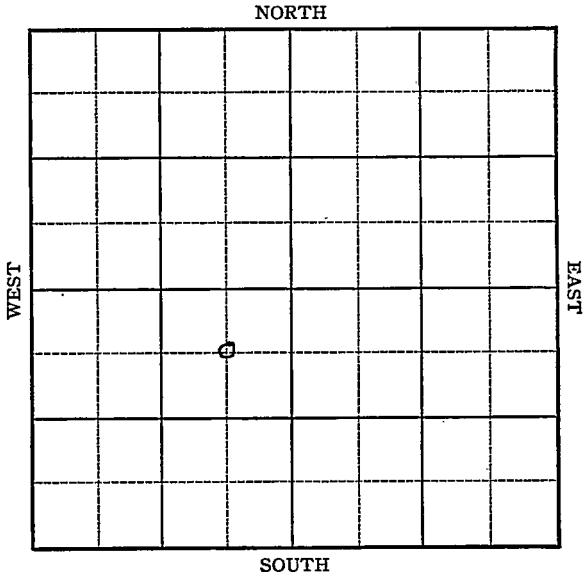

Sec. 5 Twp. 10 R. 21-E

Well No. #3 Farrar Farm


McLaughlin Company

660 Ft. from N. Line

Ft. from S. Line

660 Ft. from E. Line

Ft. from W. Line

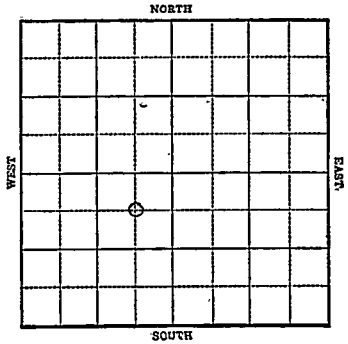

1944

R E P O R T

1-12 Location

1/19 "

1/26 "

2/2 "

2/8 "

2/15 "

2/23 "

3/1 "

3/7 "

3/16 "

3/22 "

3/2 9 Machine

4/5 "

4/12 "

4/19 "

4/26 "

5/3 "

5/10 "

5/17 "

5/24 "

OVER

1944

5/31 Mach.
6/7 "

6/21 Miss. 1294
6" @ 1302
T.D. 1488

ABANDONED

KANSAS
 Map No. MM Sec. 5 Twp. 10 R. 21E

Well No. 3 Farrar

McLaughlin Company

FIRST REPORT Contractor

C NE SW

SECTION PLAT

660 Ft. from N. Line

_____ Ft. from S. Line

660 Ft. from E. Line

_____ Ft. from W. Line

	o		

McLouth Pool

Location X

Rig up _____

Drilling and Remarks:

RECORD

Cased _____ in., _____ ft.

Sand _____

Gas _____

Oil _____

Total Depth _____

PRODUCTION

1st 24 hrs. Nat. _____

1st 24 hrs. after shot _____

Gas _____ Cu. Ft.

Dry Hole _____

Abandoned _____

Date

JAN 12 1944 19

S. J. LEWIS Scout

no wall up

Misc. Small Maps	<i>Small Map - One</i>
Cards	<i>made</i>
Tracing	
France Map	
Scarborough Map	<i>X AS</i>
Moody Map	
Crological Dept.	
Moody Plot Book	

Pool Name McLouth

KANSAS

Map No. 1111 Sec. 5 Twp. 10 R. 21E

Well No. 3 Farrar

McLaughlin Company

ABANDONED Contractor

C NE SW

SECTION PLAT

660 Ft. from N. Line

 Ft. from S. Line

660 Ft. from E. Line

 Ft. from W. Line

	6		

Leavenworth County

Location

Rig up

Drilling and Remarks:

Miss 1294
6" @ 1302.

RECORD

Cased in. ft.

Sand

Gas

Oil

Total Depth 1488

PRODUCTION

1st 24 hrs. Nat.

1st 24 hrs. after shot

Gas Cu. Ft.

Dry Hole

Abandoned

Date

JUN 21 1944 19

S. J. LEWIS Scout

no work

Misc. Small Maps	<i>Small Map. Omaha</i>
Cards	<i>Small</i>
Tracing	
France Map	<i>X</i>
Scarborough Map	<i>X</i>
Moody Map	
Geological Dept.	
Model Flat Book	

Small Map. Omaha
Small
X