


Section 5 Township 10 Range 21E

Well No. #1 Harrison

Company McGuire et al.

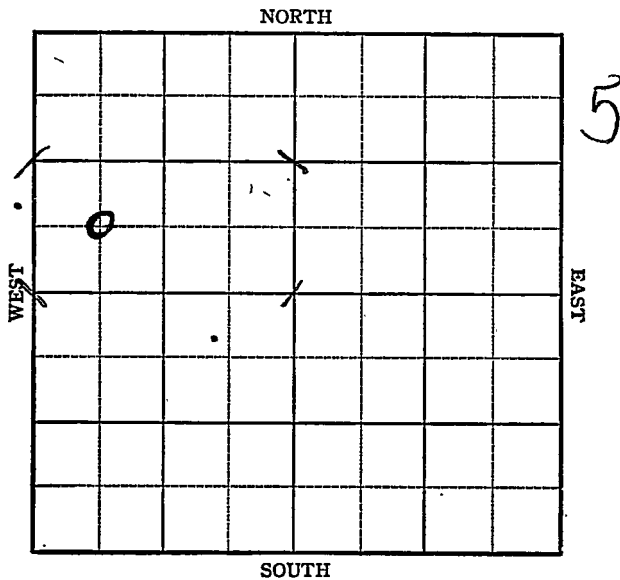


KANSAS

Leavenworth

Sec. 5 Twp. 10 R. 21-E

Well No. #1 Harrison Farm
McGuire etal Company

NORTH

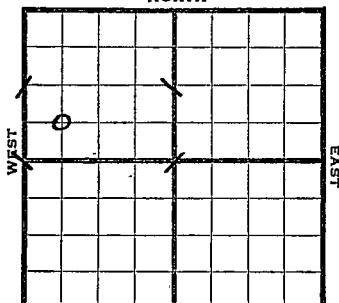

 Ft. from N. Line

660 Ft. from S. Line

 Ft. from E. Line

660 Ft. from W. Line

McLouth

R E P O R T

1944

3/15 Machine

3/22 "

3/29 Drlg. 585

4/5 " "

4/12 Miss 1342

TD 1365

ABANDONED

KANSAS

Map No. MM Sec. 5 Twp. 10 R. 21EWell No. 1 HarrisonMcGuire et al.


Company

FIRST REPORT

Contractor

C SW NW

SECTION PLAT

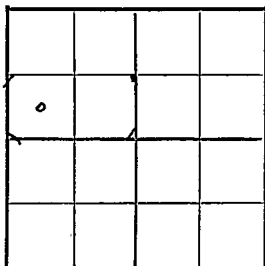 Ft. from N. Line660 . Ft. from S. Line Ft. from E. Line660 . Ft. from W. Line

McLouth Pool

Location Rig up

Drilling and Remarks:

Machine

RECORD

Cased in., ft.Sand Gas Oil Total Depth

PRODUCTION

1st 24 hrs. Nat. 1st 24 hrs. after shot Gas Cu. Ft.Dry Hole Abandoned

Date

MAR 15 1944

19

S. J. LLAND

Scout

KANSAS

Map No. NM Sec. 5 Twp. 10 R. 21EWell No. 1 HarrisonMcGuire et al. CompanyABANDONED Contractor

C SW NW

SECTION PLAT

o			

Ft. from N. Line

660 Ft. from S. Line

Ft. from E. Line

660 Ft. from W. Line

McLouth Pool

Location _____

Rig up _____

Drilling and Remarks:

Miss 1342

RECORD

Cased _____ in., _____ ft.

Sand _____

Gas _____

Oil _____

Total Depth 1365

PRODUCTION

1st 24 hrs. Nat. _____

1st 24 hrs. after shot _____

Gas _____ Cu. Ft.

Dry Hole _____

Abandoned _____

Date

APR 12 1944 19S. J. LEWIS Scout