

KANSAS


Leavenworth

FORM 51 5M PETROL

Section 5 Township 10 Range 21-E

Well No. #1 C. F. Myers

Company McGuire

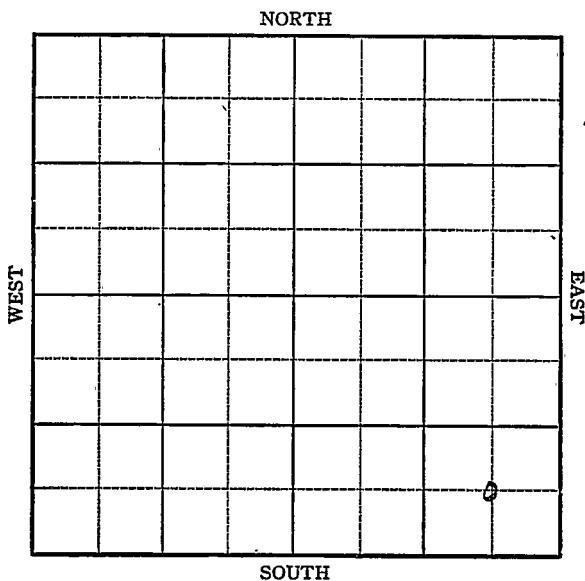

Sec. 5 Twp. 10 R. 21-E

Well No. #1 C. F. Meyer Farm


McGuire Company

_____ Ft. from N. Line

660 Ft. from S. Line

660 Ft. from E. Line

_____ Ft. from W. Line

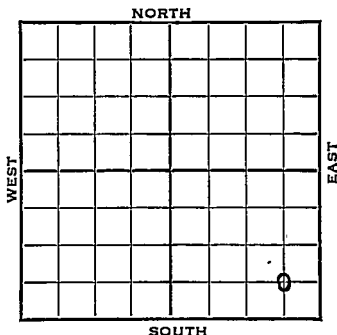

1943

REPORT

8/18 Machine

8/25 "

9/1 10" @ 22'
Drlg. 250'

9/8 Drlg. 540'

9/15 Sand 1239
Miss 1300
5" @ 1396' T.D.

9/22 " - " "

9/29 Miss 1300
5" @ 1396'
T.D. 1446'

ABANDONED

KANSAS

Map No. NM Sec. 5 Twp. 10 R. 21E

Well No. 1 C. F. Meyer

McGuire Company

FIRST REPORT Contractor

C SE SE

_____ Ft. from N. Line

660 Ft. from S. Line

660 Ft. from E. Line

_____ Ft. from W. Line

MCLOUTH POOL

SECTION PLAT

			o

Location _____

Rig up _____

Drilling and Remarks:

Mach.

RECORD

Cased _____ in., _____ ft.

Sand _____

Gas _____

Oil _____

Total Depth _____

PRODUCTION

1st 24 hrs. Nat. _____

1st 24 hrs. after shot _____

Gas _____ Cu. Ft.

Dry Hole _____

Abandoned _____

Date

AUG 18 1943 19

S. J. LEWIS Scout

KANSAS

Map No. 11 M Sec. 5 Twp. 10 R. 21EWell No. 1 C.F. MeyerMcGuire

Company

ABANDONED

Contractor

C SE SE

SECTION PLAT

 Ft. from N. Line660 Ft. from S. Line660 Ft. from E. Line Ft. from W. Line

McLouth Pool

Location Rig up

Drilling and Remarks:

Machine

*Mis 1300**5" C 1396*

RECORD

Cased in., ft.Sand Gas Oil Total Depth 1446

PRODUCTION

1st 24 hrs. Nat. 1st 24 hrs. after shot Gas Cu. Ft.Dry Hole Abandoned

Date

SEP 29 1943

19

S. J. LEWIS Scout