

KANSAS


Jefferson

FORM 51 5M 4-41 PETROL

Section 5 Township 10 Range 20-E

Well No. #1 Bower

Company Sherrod et al
~~McLaughlin et al~~

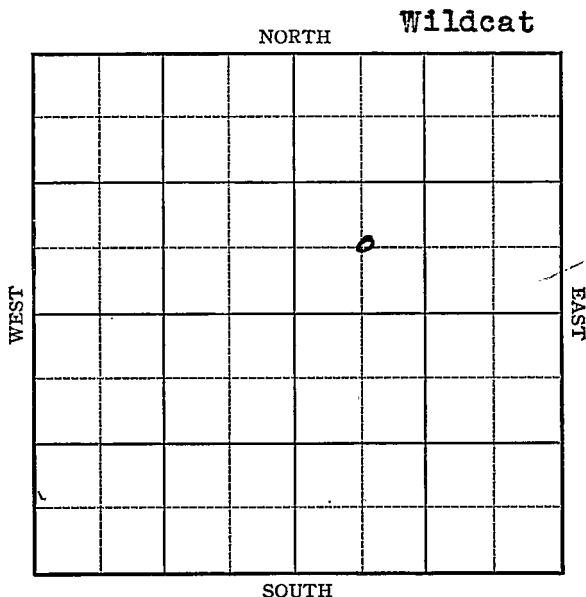

Map No. NM Sec. 5 Twp. 10 R. 20EWell No. 1 BowerMcLaughlin etal Company

Contractor

FIRST REPORT

C SW NE

 Ft. from N. Line660 Ft. from S. Line Ft. from E. Line662 Ft. from W. Line**SECTION PLAT**

		o	

WILDCATLocation Rig up

Drilling and Remarks:

10" - 22'Dr1g. 150**RECORD**Cased in., ft.Sand Gas Oil Total Depth **PRODUCTION**1st 24 hrs. Nat. 1st 24 hrs. after shot Gas Cu. Ft.Dry Hole Abandoned

Date

APR 30 1941 19 S. J. LEWIS Scout

Map No. 4M Sec. 5 Twp. 10 R. 20EWell No. 1 BowerSherrod etal CompanyCORRECTION Contractor

C SW NE

 Ft. from N. Line660 Ft. from S. Line Ft. from E. Line662 Ft. from W. Line

SECTION PLAT

		α	

WILDCAT

Location Rig up

Drilling and Remarks:

Sherrod etalhave taken thisover from McLaughlin
etal

RECORD

Cased in., ft.Sand Gas Oil Total Depth

PRODUCTION

1st 24 hrs. Nat. 1st 24 hrs. after shot Gas Cu. Ft.Dry Hole Abandoned

Date

JUN 11 194119S. J. LEWISScout

Map No. 114 Sec. 5 Twp. 10 R. 20EWell No. 1 BowerSherrod etal

Company

~~COMPLETED~~

Contractor

C SW NE

 Ft. from N. Line660 Ft. from S. Line Ft. from E. Line662 Ft. from W. Line

WILDCAT

SECTION PLAT

		o	

Location Rig up

Drilling and Remarks:

Bar 8. 1482.6 " @ 12805 " @ 1482.7400,000 Gals.

RECORD

Cased in., ft.Sand Gas Oil Total Depth 1501

PRODUCTION

1st 24 hrs. Nat. 1st 24 hrs. after shot Gas Cu. Ft.Dry Hole Abandoned

Date

JUN 25 194119S. J. LEWISScout