

KANSAS


Jefferson

FORM 51 5M 10-41 PETROL

Section 5 Township 10 Range 20-E


Well No. #2 ~~#1~~ Bower

Company ~~Mosley & Adams~~ *Apperson*

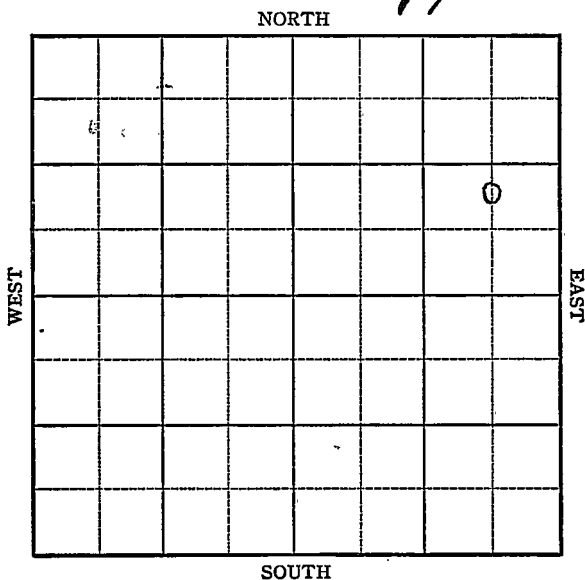

Sec. 5 Twp. 10 R. 20-EWell No. #2
#1 Bower FarmMosley & Adams Apperson Company

McLouth Pool

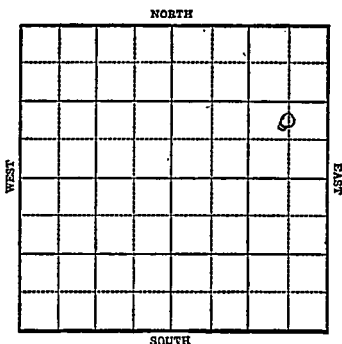 Ft. from N. Line990 Ft. from S. Line660 Ft. from E. Line Ft. from W. Line

1943

R E P O R T

3/10 Drlg. 35'

3/16 10" Casing set 591
Drlg 785'

3/24 8" @ 930
6" @ 1450
Gas 1447'
Drlg. 1462'

3/31 SD

4/7 "

4/14 "

4/21 Miss. 1483
T.D. 1491 SD

4/28 " " "

5/5 Drlg. 1562'

5/12 " "

5/19 Miss. 1483
5" - 1624
Pump 35 Pot.
T.D. 1632
Gravity 26.8

COMPLETED

KANSAS

Jefferson

Map No. MM Sec. 5 Twp. 10 R. 20EWell No. 1 Bower

Mosley & Adams

Company

FIRST REPORT

Contractor

C NL SE NE

SECTION FLAT

			o

Ft. from N. Line

990 Ft. from S. Line660 Ft. from E. Line

Ft. from W. Line

MCLOUTH POOL

Location _____

Rig up _____

Drilling and Remarks:

35' Drlg.

RECORD

Cased _____ in., _____ ft.

Sand _____

Gas _____

Oil _____

Total Depth _____

PRODUCTION

1st 24 hrs. Nat. _____

1st 24 hrs. after shot _____

Gas _____ Cu. Ft.

Dry Hole _____

Abandoned _____

Date

MAR 10 1943 19S. J. LEWIS

Scout

KANSAS Jefferson

Map No. 17 M Sec. 5 Twp. 10 R. 20EWell No. 2 BowerMosley & Adams

Company

CORRECTION

Contractor

C NL SE NE

 Ft. from N. Line990 Ft. from S. Line660 Ft. from E. Line Ft. from W. Line

SECTION PLAT

			o

MCLOUTH POOLLocation Rig up Drilling and Remarks: Have changed
from #1 to #2

RECORD

Cased in., ft.Sand Gas Oil Total Depth

PRODUCTION

1st 24 hrs. Nat. 1st 24 hrs. after shot Gas Cu. Ft.Dry Hole Abandoned

Date

MAR 24 1943

19

S. J. LEWIS

Scout

KANSAS**Jefferson**Map No. 1111 Sec. 5 Twp. 10 R. 20EWell No. 2 BowerApperson

Company

CORRECTION

Contractor

C NL SE NE**SECTION PLAT**

			0

 Ft. from N. Line990 Ft. from S. Line660 Ft. from E. Line Ft. from W. Line**MCLOUTH POOL**Location Rig up

Drilling and Remarks:

Reported as

Mosley & Adams

RECORDCased in., ft.Sand Gas Oil Total Depth **PRODUCTION**1st 24 hrs. Nat. 1st 24 hrs. after shot Gas Cu. Ft.Dry Hole Abandoned

Date

APR 2 1943

19

S. J. LEWIS Scout

Jefferson

KANSAS

Map No. 111 Sec. 5 Twp. 10 R. 20EWell No. 2 Bower

Apperson

Company

COMPLETED

Contractor

C NL SE NE

SECTION PLAT

			o

Ft. from N. Line

990

Ft. from S. Line

660

Ft. from E. Line

Ft. from W. Line

MCLOUTH POOL

Location

Rig up

Drilling and Remarks:

Miss 1483

5" C 1624

Pump. 35 Ps

26 5 1/2

RECORD

Cased _____ in., _____ ft.

Sand _____

Gas _____

Oil _____

Total Depth 1632

PRODUCTION

1st 24 hrs. Nat. _____

1st 24 hrs. after shot _____

Gas _____ Cu. Ft.

Dry Hole _____

Abandoned _____

Date

MAY 19 1943 19

S. J. LEWIS Scout