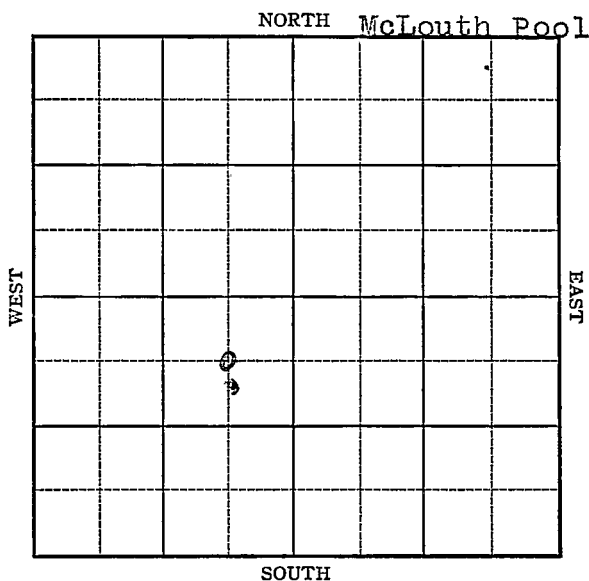


KANSAS

Jefferson

FORM 51 5M 1-42 PETROL

Section 5 Township 10 Range 20-EWell No. #1 BowerCompany Hatcher Fisk

Sec. 5 Twp. 10 R. 20-E

Well No. #1 Bower Farm

Hatcher Disk _____ Company

(McLouth)


660 Ft. from N. Line

Ft. from S. Line

660 Ft. from E. Line

Ft. from W. Line

Ex 1177

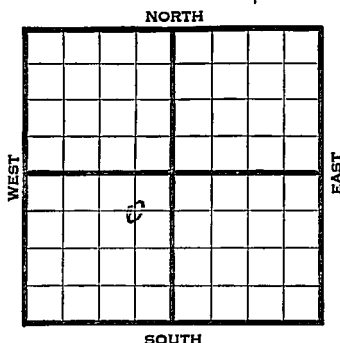[illegible]

Jefferson

KANSAS

Map No. 111 Sec. 5 Twp. 10 R. 20EWell No. 1 Bower

Hatcher Fisk

Company

FIRST REPORT

Contractor

C NE SW

660 Ft. from N. Line

Ft. from S. Line

660 Ft. from E. Line

Ft. from W. Line

SECTION PLAT

	o		

MCLOUTH POOL

Location

Rig up

Drilling and Remarks:

10" - 105'

737' Fishing

RECORD

Cased _____ in., _____ ft.

Sand _____

Gas _____

Oil _____

Total Depth _____

PRODUCTION

1st 24 hrs. Nat. _____

1st 24 hrs. after shot _____

Gas _____ Cu. Ft.

Dry Hole _____

Abandoned _____

Date

APR 8 1942 19

S. J. LEWIS Scout

KANSAS

Jefferson

Map No. MM Sec. 5 Twp. 10 R. 20 EWell No. 1 Bower

Hatcher Fisk

Company

COMPLETED

Contractor

C NE SW

SECTION PLAT

	0		

660 Ft. from N. Line

Ft. from S. Line

660 Ft. from E. Line

Ft. from W. Line

MCLOUTH POOL

Location

Rig up

Drilling and Remarks:

Sand 15275" C 15276,200,000 cu ft
Gas

RECORD

Cased _____ in., _____ ft.

Sand _____

Gas _____

Oil _____

Total Depth 1544

PRODUCTION

1st 24 hrs. Nat. _____

1st 24 hrs. after shot _____

Gas _____ Cu. Ft.

Dry Hole _____

Abandoned _____

Date

APR 29 1942 19

S. J. LEWIS Scout