

KANSAS


Jefferson

FORM 51 5M 4-41 PETROL

Section 5 Township 10 Range 20E

Well No. 1-Bower

Company Longwell et al

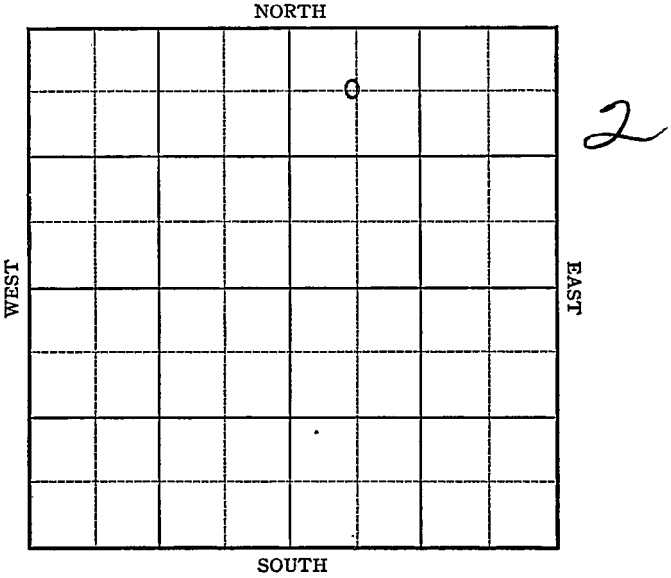

Map No. _____ Sec. 5 Twp. 10 R. 20EWell No. 1 BowerLongwell etal CompanyFIRST REPORT Contractor

SECTION PLAT

		o	

660 C NW NE
Ft. from N. Line

____ Ft. from S. Line

____ Ft. from E. Line

660 Ft. from W. Line

MISCELLANEOUS

Location _____

Rig up _____

Drilling and Remarks:

Machine

RECORD

Cased _____ in., _____ ft.

Sand _____

Gas _____

Oil _____

Total Depth _____

PRODUCTION

1st 24 hrs. Nat. _____

1st 24 hrs. after shot _____

Gas _____ Cu. Ft.

Dry Hole _____

Abandoned _____

Date

SEP 3 1941 19S. J. LEWIS Scout

