


# KANSAS

# Jefferson

FORM 51 5M 10-41 PETROL

Section 5 Township 10 Range 20EWell No. 1 Bower 18 A.Company Longwell Oil

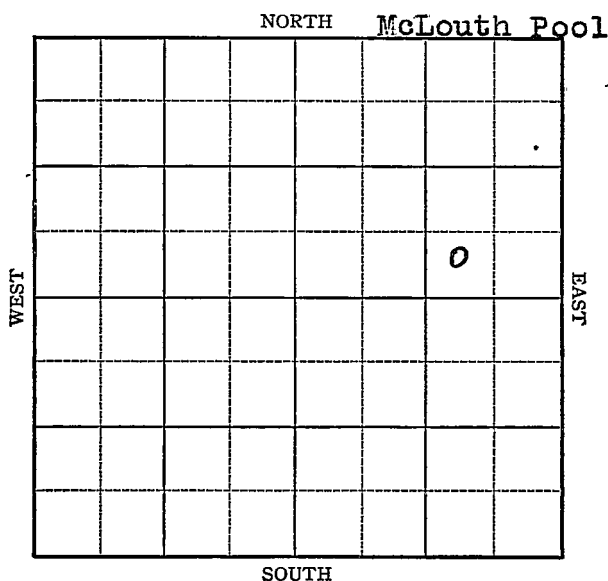

Map No. MM Sec. 5 Twp. 10 R. 20EWell No. 1 Bower 18 A.Longwell Oil CompanyFIRST REPORT Contractor

SW SE NE

## SECTION PLAT

|  |  |  |          |
|--|--|--|----------|
|  |  |  |          |
|  |  |  | 12<br>01 |
|  |  |  |          |
|  |  |  |          |

       Ft. from N. Line415 Ft. from S. Line907 Ft. from E. Line       Ft. from W. Line

## MCLOUTH POOL

## RECORD

Location                     Cased            in.,            ft.Rig up                     Sand                     

Drilling and Remarks:

Gas                     Oil                     

10" - 55'

Total Depth                     Waiting on  
cement to set

## PRODUCTION

1st 24 hrs. Nat.                     1st 24 hrs. after shot                     Gas                      Cu. Ft.Dry Hole                     Abandoned                     

Date

JAN 14 1942

19

S. J. LEWIS Scout

Jefferson **KANSAS**Map No. NM Sec. 5 Twp. 10 R. 20EWell No. 1 Bower 18 A.Longwell Oil Company**COMPLETED** Contractor

SW SE NE

       Ft. from N. Line415 Ft. from S. Line907 Ft. from E. Line       Ft. from W. Line

## SECTION PLAT

|  |  |  |  |
|--|--|--|--|
|  |  |  |  |
|  |  |  |  |
|  |  |  |  |
|  |  |  |  |
|  |  |  |  |

MCLOUTH POOL

Location                                 Rig up                                 

Drilling and Remarks:

*Mis 1489**6" @ 1492**Pump 50 P.Y.**23° Gr*

## RECORD

Cased            in.,            ft.Sand                                 Gas                                 Oil                                 Total Depth 163 1/2

## PRODUCTION

1st 24 hrs. Nat.                                 1st 24 hrs. after shot                                 Gas                                  Cu. Ft.Dry Hole                                 Abandoned                                 

Date

FEB 25 1942

19

S. J. LEWIS Scout