

# KANSAS

FORM 51 5M 10-41 PETROL

Jefferson


Section 5 Township 10 Range 20-E

Well No. #2 Bower

Company Sherrod

McLouth Pool

NORTH

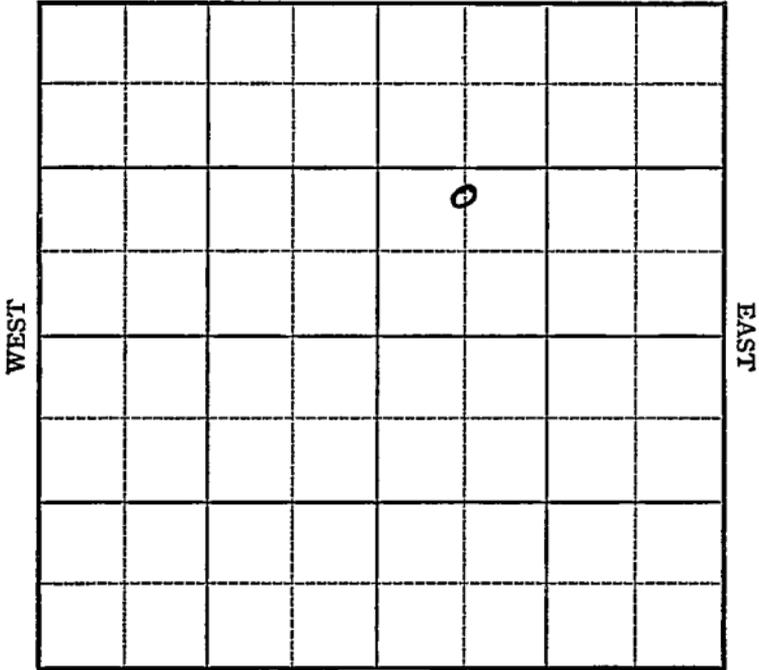

SOUTH

Sec. 5 Twp. 10 R. 20-E

Well No. #2 Bower Farm

Sherrod Company

(McLouth Pool)


\_\_\_\_\_ Ft. from N. Line

1060 Ft. from S. Line

\_\_\_\_\_ Ft. from E. Line

660 Ft. from W. Line

Elev. 1136

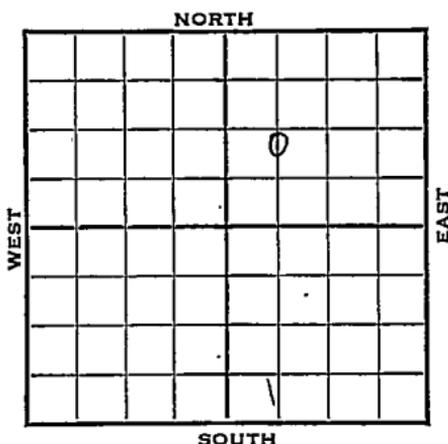

1942

REPORT

8/27

10" - 60

Drlg. 580' Oil Test.

9/2

8" - 820 Drlg. 850'

9/9

Drlg 907

9/16

6" @ 1455 Bart 1465 Drlg 1503

Bart. 1465

9/23

Miss. 1525

6" 1455

TD 1648

Pump 35 oil

29 Grav.

COMPLETED

Map No. AM Sec. 5 Twp. 10 R. 20E

Well No. 2 Bower

Sherrod Company

**FIRST REPORT** Contractor

C NL SW NE

SECTION PLAT

\_\_\_\_\_ Ft. from N. Line

1060 Ft. from S. Line

\_\_\_\_\_ Ft. from E. Line

660 Ft. from W. Line

|  |  |   |  |
|--|--|---|--|
|  |  |   |  |
|  |  | o |  |
|  |  |   |  |
|  |  |   |  |
|  |  |   |  |

MCLOUTH POOL

Location \_\_\_\_\_

Rig up \_\_\_\_\_

Drilling and Remarks:

10"-60'

Drlg. 580'

Oil Test

RECORD

Cased \_\_\_\_\_ in., \_\_\_\_\_ ft.

Sand \_\_\_\_\_

Gas \_\_\_\_\_

Oil \_\_\_\_\_

Total Depth \_\_\_\_\_

PRODUCTION

1st 24 hrs. Nat. \_\_\_\_\_

1st 24 hrs. after shot \_\_\_\_\_

Gas \_\_\_\_\_ Cu. Ft.

Dry Hole \_\_\_\_\_

Abandoned \_\_\_\_\_

Date

AUG 27 1942 19

S. J. LEWIS Scout

KANSAS

Jefferson

Map No. VM Sec. 5 Twp. 10 R. 20EWell No. 2 BowerSherrod

Company

**COMPLETED**

Contractor

C NL SW NE

## SECTION PLAT

         Ft. from N. Line1060 Ft. from S. Line         Ft. from E. Line660 Ft. from W. Line

|  |  |   |  |
|--|--|---|--|
|  |  |   |  |
|  |  | o |  |
|  |  |   |  |
|  |  |   |  |
|  |  |   |  |

MCGLOUTH POOL

## RECORD

Location                                 Cased          in.,          ft.Rig up                                 Sand                                 

Drilling and Remarks:

Gas                                 Oil                                 *Miss 1525.*Total Depth 1648.*6" C 1455.*

## PRODUCTION

1st 24 hrs. Nat.                                 1st 24 hrs. after shot                                 Gas                                  Cu. Ft.Dry Hole                                 Abandoned                                 *Bar 1465.**3 5 oil Pump.**29° Gr*

Date

SEP 23 1942

19

S. J. LEWIS Scout