

KANSAS

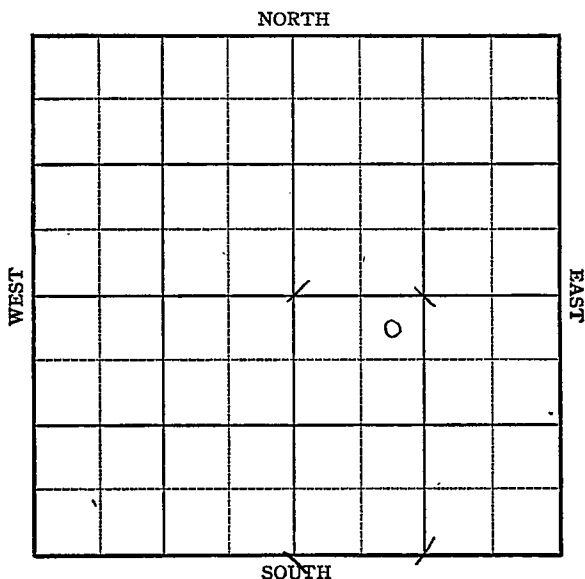
Jefferson

FORM 51 5M 10-41 PETROL

Section 5 Township 10 Range 20-E

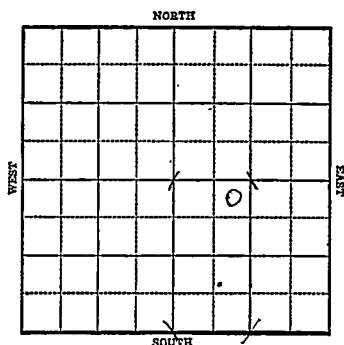
Well No. #4 McLeod

Company E. V. Jackson



Sec. 5 Twp. 10 R. 20-EWell No. #4 McLeod FarmE. V. Jackson Company

McLouth Pool

330 Ft. from N. Line Ft. from S. Line Ft. from E. Line990 Ft. from W. Line

1943

R E P O R T

3/10 Location

3/16 Machine

3/24 12" @ 66'
Drlg. 202'

3/31 SD

4/7 SD

4/14 8" @ 925'
Drlg. 1050'4/21 Sand 1430
6" @ 1458
Miss. 11503
T.D. 1595 SO

4/28 Drlg. 1610'

5/5 5" @ 1624 CO.

5/12 " " "

5/19 Miss. 1503
5" - 1624
Pump 50 Pot.
T.D. 1646
Gravity 26.9

COMPLETED

Jefferson

KANSAS

Map No. 111 Sec. 5 Twp. 10 R. 20^LWell No. 4 McLeod

E. V. Jackson

Company

FIRST REPORT

Contractor

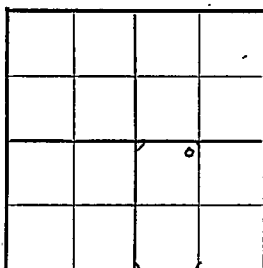
NE NW SE

SECTION PLAT

330 Ft. from N. Line

Ft. from S. Line

Ft. from E. Line

990 Ft. from W. Line

MCLOUTH POOL

Location XXX

Rig up

Drilling and Remarks:

RECORD

Cased _____ in., _____ ft.

Sand _____

Gas _____

Oil _____

Total Depth _____

PRODUCTION

1st 24 hrs. Nat. _____

1st 24 hrs. after shot _____

Gas _____ Cu. Ft.

Dry Hole _____

Abandoned _____

Date

MAR 10 1943 19

S. J. LEWIS

Scout

KANSAS**Jefferson**Map No. MM Sec. 5 Twp. 10 R. 20EWell No. 4 McLeodE. V. Jackson

Company

COMPLETED

Contractor

NE NW SE

330

Ft. from N. Line

Ft. from S. Line

Ft. from E. Line

990

Ft. from W. Line

SECTION PLAT

		0	

MCLOUTH POOL

Location

Rig up

Drilling and Remarks:

*Miss 1503**5" C 1624**Pump 50 Bx.**26 7/8***RECORD**

Cased _____ in., _____ ft.

Sand _____

Gas _____

Oil _____

Total Depth 1646**PRODUCTION**

1st 24 hrs. Nat. _____

1st 24 hrs. after shot _____

Gas _____ Cu. Ft.

Dry Hole _____

Abandoned _____

Date

MAY 19 1943

19

S. J. LEWIS Scout