


Section 5 Township 10 Range 20-E

Well No. #4 Bower

Company Sherrod etal

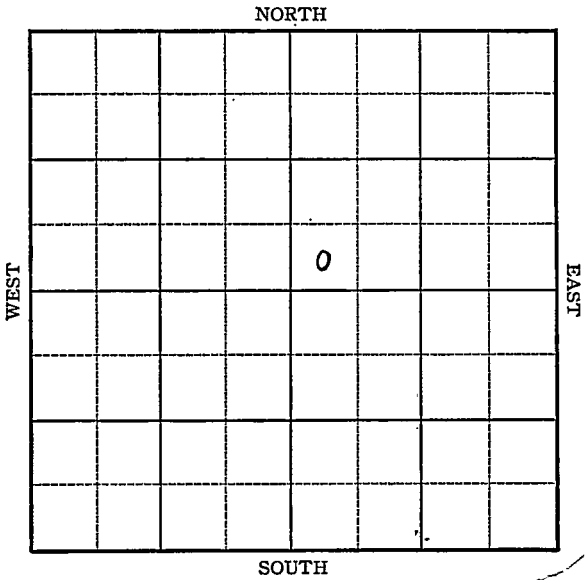

Sec. 5 Twp. 10 R. 20-E

Well No. #4 Bower Farm


Sherrod et al. Company

_____ Ft. from N. Line

330 Ft. from S. Line

_____ Ft. from E. Line

330 Ft. from W. Line

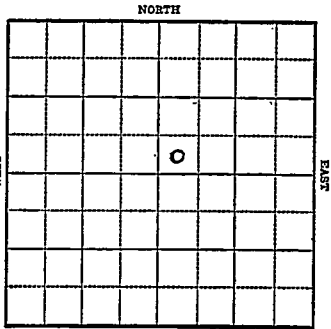

McLouth Pool

Elev. 1158 SOUTH

1943

R E P O R T

7/28	10"-851' Drlg. 270'
8/4	Drlg. 700'
8/11	" "
8/18	Drlg. 1345' 8" @ 985' 6" @ 1260'
8/25	" "
9/1	1345' fsg.
9/8	" "
9/15	Drlg. 1356'
9/22	Drlg. 1405
9/29	Sand 1483 Miss 1546 T.D. 1560 SD
10/6	Drlg. 1610'
10/13	Drlg. 1635'
10/20	5" @ 1546 T.D. 1635' C.O.
10/27	SD
11/3	"
11/10	"

OVER

943		
11/17	TD 1635	SD
11/24	" "	
12/1	" "	
12/8	" "	
12-15	" "	
	" "	
12/22	" "	
12/29	" "	
1948		
1-5	"	"
1-12	"	"
1/19	"	"
1/26	"	"
	"	"
2/2	"	"
	"	"
2/8	"	"
2/15	"	"
2/23	"	"
3/1	"	"
3/7	"	"
3/15	"	"
3/22	"	"
3/29	"	"
4/5	"	"
4/12	"	"
4/19	"	"
4/26	"	"
5/3	"	"
5/10	1645 fsg	
5/17	Miss. 1546	
	5" - 1546	
	Total Depth 1645	

ABANDONED.

KANSAS

Jefferson

Map No. MM Sec. 5 Twp. 10 R. 20E

Well No. 4 Bower

Sherrod et al. Company

FIRST REPORT

Contractor

SW NE

SECTION PLAT

_____ Ft. from N. Line

330 Ft. from S. Line

_____ Ft. from E. Line

330 Ft. from W. Line

M CLOUTH POOL

Location _____

Rig up _____

Drilling and Remarks:

10"-851'

Drlg. 270'

RECORD

Cased _____ in., _____ ft.

Sand _____

Gas _____

Oil _____

Total Depth _____

PRODUCTION

1st 24 hrs. Nat. _____

1st 24 hrs. after shot _____

Gas _____ Cu. Ft.

Dry Hole _____

Abandoned _____

Date

JUL 28 1943 19

S. J. LEWIS Scout

no wall map

Misc. Small Maps
Cards
Tracing
France Map
Scarborough Map
Moody Map
Geological Dept.
Moody Flat Book

No small map @ ma

Book

X

Pool Name McLouth

Map No. KANSAS W 1/4 Sec. 5 Twp. 10 R. 20E

Well No. 4 Bower

Sherrod et al. Company

ABANDONED Contractor

SW NE

SECTION PLAT

 Ft. from N. Line

330 Ft. from S. Line

 Ft. from E. Line

330 Ft. from W. Line

Jefferson County

RECORD

Location

Cased in., ft.

Rig up

Sand

Drilling and Remarks:

Gas

Misc 1546

Oil

5" @ 1546

Total Depth 1645

PRODUCTION

1st 24 hrs. Nat.

1st 24 hrs. after shot

Gas Cu. Ft.

Dry Hole

Abandoned

Date

MAY 17 1944 19

S. J. LEWIS Scout

no more

Misc. Small Maps	<i>no Small Map Omia</i>
Cards	<i>Omia</i>
Tracing	
France Map	X
Scarborough Map	X
Moody Map	
Geological Dept.	
Moody Flat Book	

no Small Map Omia