

KANSAS


FORM 51 5M PETROL

Jefferson

Section 5 Township 10 Range 20-E

Well No. #1 Mabel Bowers

Company Jackson

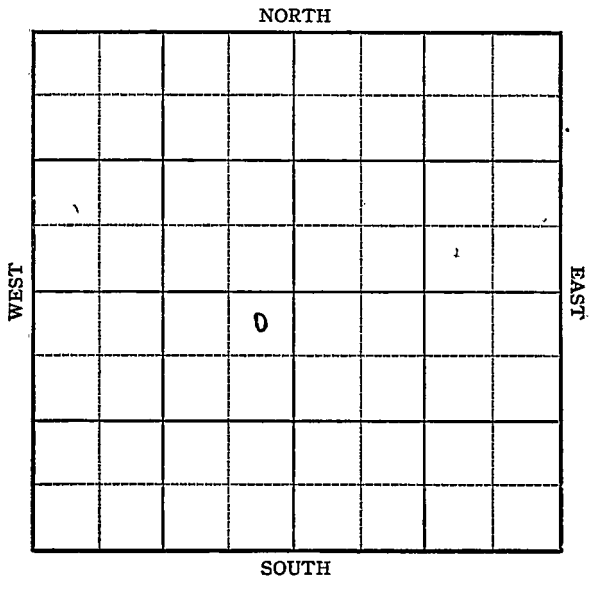

KANSAS

Map No. 222 Sec. 5 Twp. 10 R. 20E

Well No. 1 Mabel Bowers

Jackson

Company

FIRST REPORT

Contractor

NE SW

SECTION PLAT

330 Ft. from N. Line

_____ Ft. from S. Line

330 Ft. from E. Line

_____ Ft. from W. Line

McLouth Pool

RECORD

Location _____

Cased _____ in., _____ ft.

Rig up _____

Sand _____

Drilling and Remarks:

Gas _____

Machine

Oil _____

Total Depth _____

PRODUCTION

1st 24 hrs. Nat. _____

1st 24 hrs. after shot _____

Gas _____ Cu. Ft.

Dry Hole _____

Abandoned _____

Date

SEP 1 1943 19

S. J. LEWIS Scout

KANSAS

Map No. 17171 Sec. 5 Twp. 10 R. 20E

Well No. 1 Mabel Bowers

Jackson Company

ABANDONED Contractor

NE SW

SECTION PLAT

330 Ft. from N. Line

_____ Ft. from S. Line

330 Ft. from E. Line

_____ Ft. from W. Line

	o		

McLouth Pool

Location _____

Rig up _____

Drilling and Remarks:

Machine

Mias 1558

6" C 1563

RECORD

Cased _____ in., _____ ft.

Sand _____

Gas _____

Oil _____

Total Depth 1712

PRODUCTION

1st 24 hrs. Nat. _____

1st 24 hrs. after shot _____

Gas _____ Cu. Ft.

Dry Hole _____

Abandoned _____

Date

SEP 29 1943 19

S. J. LEWIS Scout