


Section 5 Township 10 Range 20E

Well No. 1 McLoud

Company J. Epperson et al

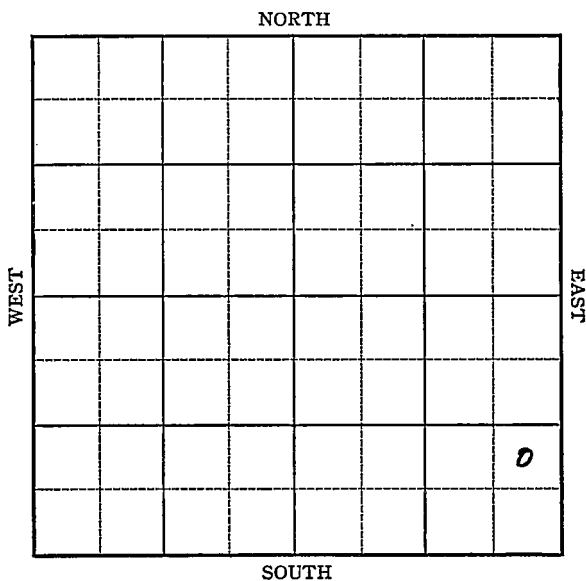


16

KANSAS

Jefferson

Sec. 5 Twp. 10 R. 20-EWell No. #1 McCloud FarmJ. Epperson et al Company

(Misc.)

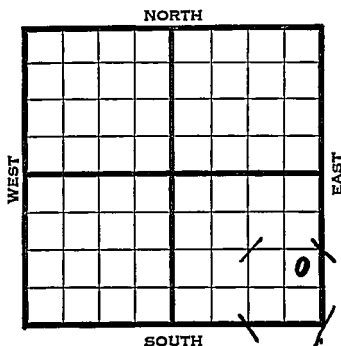 Ft. from N. Line990 Ft. from S. Line330 Ft. from E. Line Ft. from W. Line

1941	REPORT
6/11	Machine.
6/19	Drlg. 630'
6/26	S/Gas 1470' SS0 1545-52.
	Drlg. 1560'
7/3	Miss. 1504' 6" - 1608'
	T.D. 1649' 800,000 cu. ft.
	gas 1478-84'
7/10	P.B. to 1526'
7/17	P.B. to 1481' 350,000 cu. ft.
	gas.
7/23	Miss. 1504'
	6" - 1608'
	T.D. 1649'
	Bur gess 1478'
	P.B. to 1481'
	350,000 cu. ft. gas.
	COMPLETED

Map No. 11 1/2 Sec. 5 Twp. 10 R. 20EWell No. 1 McCloudJ. Epperson et al Company

Contractor

FIRST REPORT

NE SE SE

 Ft. from N. Line990 Ft. from S. Line330 Ft. from E. Line Ft. from W. Line

SECTION PLAT

MISCELLANEOUS

Location Rig up

Drilling and Remarks:

Machine

RECORD

Cased in., ft.Sand Gas Oil Total Depth

PRODUCTION

1st 24 hrs. Nat. 1st 24 hrs. after shot Gas Cu. Ft.Dry Hole Abandoned

Date

JUN 1 1 1941 19

S. J. LEWIS Scout

Map No. NM Sec. 5 Twp. 10 R. 20EWell No. 1 McCloudJ. Epperson etal CompanyCOMPLETED Contractor

NE SE SE

 Ft. from N. Line990 Ft. from S. Line330 Ft. from E. Line Ft. from W. Line

SECTION PLAT

			o

MISCELLANEOUS

Location Rig up

Drilling and Remarks:

*Miss 1504**6 "C 1608.**Burger 1478**P.B. 1451**350,000 cu ft Gas*

RECORD

Cased in., ft.Sand Gas Oil Total Depth 1649

PRODUCTION

1st 24 hrs. Nat. 1st 24 hrs. after shot Gas Cu. Ft.Dry Hole Abandoned

Date

JUL 23 1941 19 S. J. LEWIS Scout