


Section 5 Township 10 Range 20-E

Well No. #1 McLeod

Company Loiquist

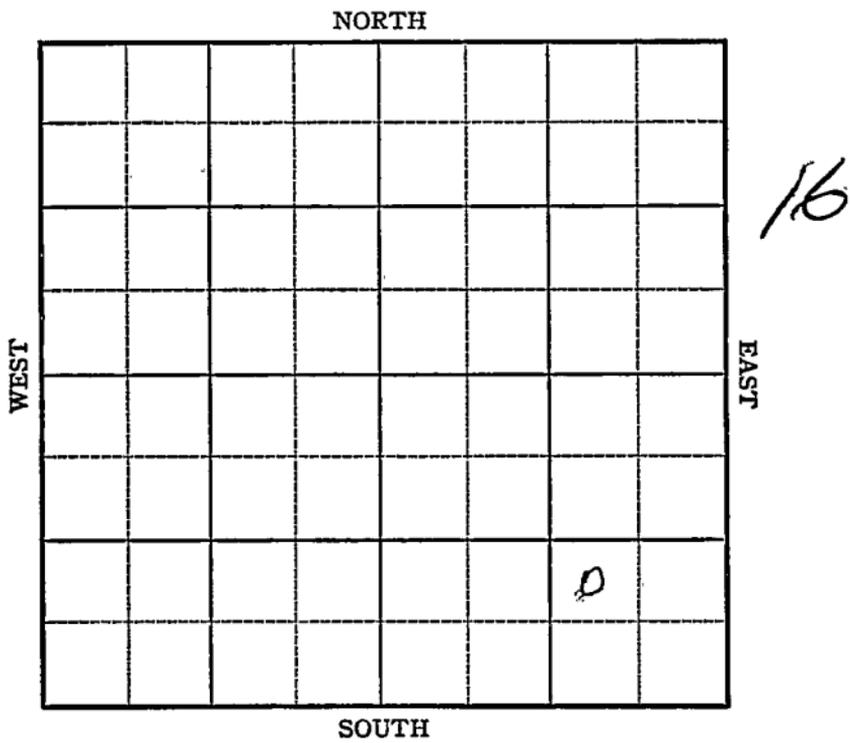

Sec. 5 Twp. 10 R. 20-E

Well No. #1 McLeod Farm
Lofquist Company


McLouth

_____ Ft. from N. Line

990 Ft. from S. Line

990 Ft. from E. Line

_____ Ft. from W. Line

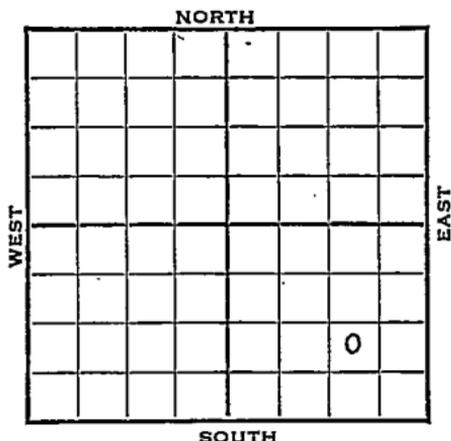

NW SE^{SS}E Elev. 1155

1943 REPORT

- 1/20 Machine
- 1/27 "
- 2/3 10" casing set 40'
Drlg. 600'
- 2/10 8" @ 960'
Drlg. 1045'
- 2/17 6" Casing set 1444'
1456-1200' oil 24 hrs
TD 1460'
- 2/24 Bart 1485'
Miss 1532
TD 1660-1200' oil
- 3/3 SD
- 3/10 "
- 3/17 Miss. 1532
6" @ 1444'
T/D. 1660'
Pump 50 pot.
Gravity 26

COMPLETED

KANSAS
 Map No. W/M Sec. 5 Twp. 10 R. 20E

Well No. 1 McLeod

Lofquist Company

Contractor

NW SE SE

_____ Ft. from N. Line

990 Ft. from S. Line

990 Ft. from E. Line

_____ Ft. from W. Line

SECTION PLAT

| | | | |
|--|--|--|---|
| | | | |
| | | | |
| | | | |
| | | | o |

MCLOUTH POOL

Location _____

Rig up _____

Drilling and Remarks:

Machine

RECORD

Cased _____ in., _____ ft.

Sand _____

Gas _____

Oil _____

Total Depth _____

PRODUCTION

1st 24 hrs. Nat. _____

1st 24 hrs. after shot _____

Gas _____ Cu. Ft.

Dry Hole _____

Abandoned _____

Date

JAN 20 1943 19

S. I. LEWIS Scout

KANSAS

Map No. MM Sec. 5 Twp. 10 R. 20E

Well No. 1 McLeod

Lofquist Company

COMPLETED

Contractor

NW SE SE

_____ Ft. from N. Line

990 Ft. from S. Line

990 Ft. from E. Line

_____ Ft. from W. Line

SECTION PLAT

| | | | |
|--|--|--|---|
| | | | |
| | | | |
| | | | |
| | | | o |

MCLOUTH POOL

Location _____

Rig up _____

Drilling and Remarks:

Miss 1532

LC1444

Pump 50 P.S.

26° Gr

RECORD

Cased _____ in., _____ ft.

Sand _____

Gas _____

Oil _____

Total Depth 1660

PRODUCTION

1st 24 hrs. Nat. _____

1st 24 hrs. after shot _____

Gas _____ Cu. Ft.

Dry Hole _____

Abandoned _____

Date

MAR 17 1943 19

S. J. LEWIS Scout