

# KANSAS

FORM 51 5M 10-41 PETROL

Jefferson

Section 5 Township 10 Range 20E

Well No. #3 McLeod

Company Jackson et al.

McLouth Pool

NORTH

|  |  |  |  |  |  |  |  |
|--|--|--|--|--|--|--|--|
|  |  |  |  |  |  |  |  |
|  |  |  |  |  |  |  |  |
WEST

EAST

SOUTH

10

0

**KANSAS**

Jefferson

Sec. 5 Twp. 10 R. 20-E

Well No. #3 McLeod Farm

Jackson et al. Company


McLouth Pool

990 Ft. from N. Line

       Ft. from S. Line

       Ft. from E. Line

990 Ft. from W. Line

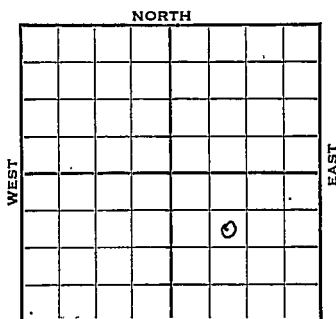

SE NW SE 1142 DF 1140 Gr. (Est)

1942

REPORT

|       |                                                                                |
|-------|--------------------------------------------------------------------------------|
| 12/2  | Machine                                                                        |
| 12/9  | 10" @ 67'<br>Drlg. 195'                                                        |
| 12/16 | Drlg. 1010'<br>8" @ 930'                                                       |
| 12/22 | 6" @ 1508'<br>Drlg. 1565'                                                      |
| 12/29 | Miss. 1532 SO 1532-45<br>6" - 1536 C O.                                        |
| 1943  |                                                                                |
| 1/6   | 6" casing set at 1508<br>T. D. 1645'<br>700' oil 12 hrs.                       |
| 1/13  | SD                                                                             |
| 1/20  | 6" Casing set 1578' SD.                                                        |
| 1/27  | " " " " "                                                                      |
| 2/3   | Miss. 1532'<br>6" casing set 1578'<br>T.D. 1645'<br>Pump 35 Bot.<br>Gravity 28 |

**COMPLETED**

Jefferson

KANSAS

Map No. 1111 Sec. 5 Twp. 10 R. 20EWell No. 3 McLeodJackson et al.

Company

**FIRST REPORT**

Contractor

SE NW SE

## SECTION FLAT

990


Ft. from N. Line

Ft. from S. Line

Ft. from E. Line

990

Ft. from W. Line

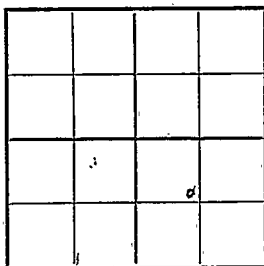

## MCLOUTH POOL

Location \_\_\_\_\_

Rig up \_\_\_\_\_

Drilling and Remarks:

Machine \_\_\_\_\_

## RECORD

Cased \_\_\_\_\_ in., \_\_\_\_\_ ft.

Sand \_\_\_\_\_

Gas \_\_\_\_\_

Oil \_\_\_\_\_

Total Depth \_\_\_\_\_

## PRODUCTION

1st 24 hrs. Nat. \_\_\_\_\_

1st 24 hrs. after shot \_\_\_\_\_

Gas \_\_\_\_\_ Cu. Ft.

Dry Hole \_\_\_\_\_

Abandoned \_\_\_\_\_

Date

DEC 2 1942 19

S. J. LEWIS

Scout

KANSAS Jefferson

Map No. AM Sec. 5 Twp. 10 R. 20EWell No. 3 McLeodJackson et al.

Company

COMPLETED

Contractor

SE NW SE

SECTION PLAT

990 Ft. from N. Line       Ft. from S. Line       Ft. from E. Line990 Ft. from W. Line

|  |  |  |  |
|--|--|--|--|
|  |  |  |  |
|  |  |  |  |
|  |  |  |  |
|  |  |  |  |
|  |  |  |  |

MCLOUTH POOL

Location                     Rig up                     

Drilling and Remarks:

*Wells 1582**6" C 1578**Pump 35 Bbl.**25° Gr*

## RECORD

Cased            in.,            ft.Sand                     Gas                     Oil                     Total Depth 1645

## PRODUCTION

1st 24 hrs. Nat.                     1st 24 hrs. after shot                     Gas                      Cu. Ft.Dry Hole                     Abandoned                     

Date

FEB 3 1943 19

S. J. LEWIS Scout