

KANSAS


Jefferson

FORM 51 5M 4-41 PETROL

Section 5 Township 10 Range 20-E

Well No. #3 McLeod

Company Longwell & Young

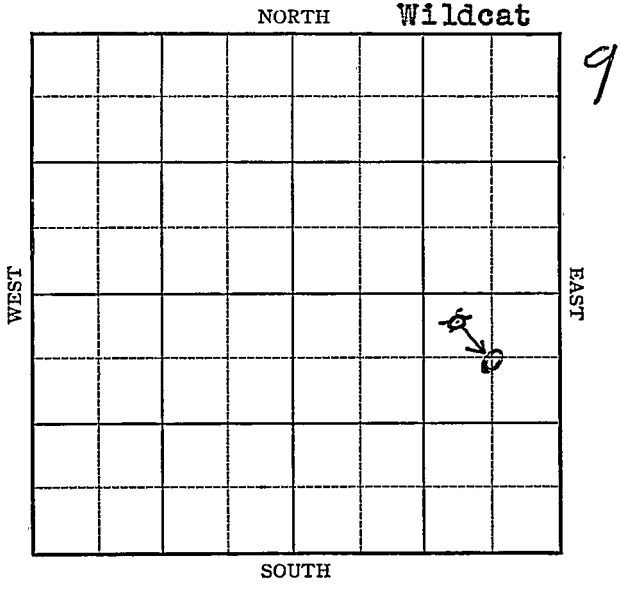

Sec. 5 Twp. 10 R. 20-E

Well No. #3 McLeod Farm
Longwell & Young Company


(Wildcat)

~~330~~ ⁶⁶⁰ Ft. from N. Line

_____ Ft. from S. Line

~~990~~ ⁶⁶⁰ Ft. from E. Line

_____ Ft. from W. Line

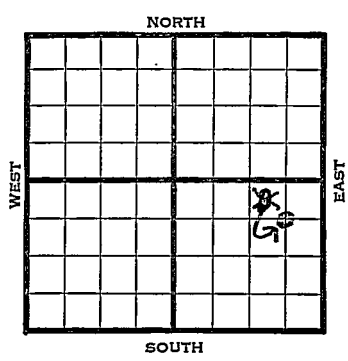

1941	REPORT
4/30	10" - 65' Drlg. 690'
5/8	8" - 867' Drlg. 1280'
5/15	8" - 1400' Drlg. 1475'
5/22	T.D. 1643' 800' oil 1 hour. Shut down.
5/28	Miss. 1515' T.D. 1644' S. O.
6/5	"
6/12	"
6/19	"
6/26	Shut down.
7/1	Bart. 1461' 8" - 1400' T.D. 1551' Miss. 1515' 6" - 1515' Potential 50 bbls., pump. 22. Gravity
	COMPLETED

Map No. NM Sec. 5 Twp. 10 R. 20EWell No. 3 McLeodLongwell & Young CompanyCORRECTION Contractor

C NE SE

660 Ft. from N. Line

_____ Ft. from S. Line

660 Ft. from E. Line

_____ Ft. from W. Line

SECTION PLAT

			o

WILDCAT

Location _____

Rig up _____

Drilling and Remarks:

Reported

NW NE SE

RECORD

Cased _____ in., _____ ft.

Sand _____

Gas _____

Oil _____

Total Depth _____

PRODUCTION

1st 24 hrs. Nat. _____

1st 24 hrs. after shot _____

Gas _____ Cu. Ft.

Dry Hole _____

Abandoned _____

Date

MAY 22 1941 19S. J. LEWIS Scout

Map No. NM Sec. 5 Twp. 10 R. 20E

Well No. 3 McLeod

Longwell & Young Company

Contractor

COMPLETED

C NE SE

660 Ft. from N. Line

_____ Ft. from S. Line

660 Ft. from E. Line

_____ Ft. from W. Line

WILDCAT

SECTION PLAT

			o

RECORD

Location _____

Cased _____ in., _____ ft.

Rig up _____

Sand _____

Drilling and Remarks: *✓*

Gas _____

Bar 1461

Oil _____

8" C 1400

Total Depth 1551

Miss 1515

6" C 1515

Pump 50 P.D.

PRODUCTION

1st 24 hrs. Nat. _____

1st 24 hrs. after shot _____

Gas _____ Cu. Ft.

Dry Hole _____

Abandoned _____

22 3/4

Date

Jul 1 1941 S. J. LEWIS Scout