

# KANSAS


Jefferson

FORM 51 5M 10-41 PETROL

Section 5 Township 10 Range 20-E

Well No. ~~#~~ #4 McLeod

Young &  
Company Longwell

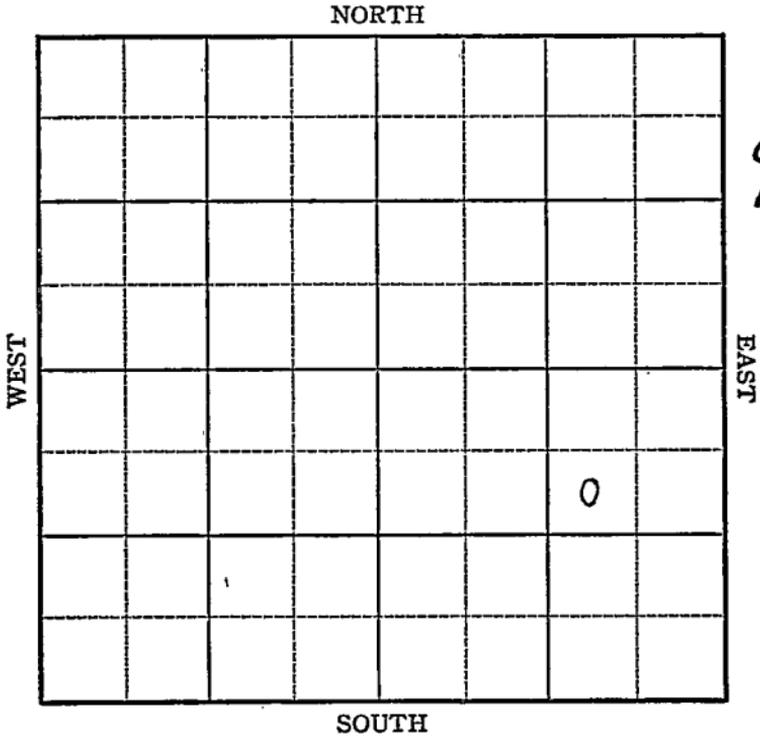

Sec. 5 Twp. 10 R. 20-E

 Well No. #4 #2 McLeod Farm

Longwell Young + Longwell Company


McLouth

990 Ft. from N. Line

Ft. from S. Line

990 Ft. from E. Line

Ft. from W. Line

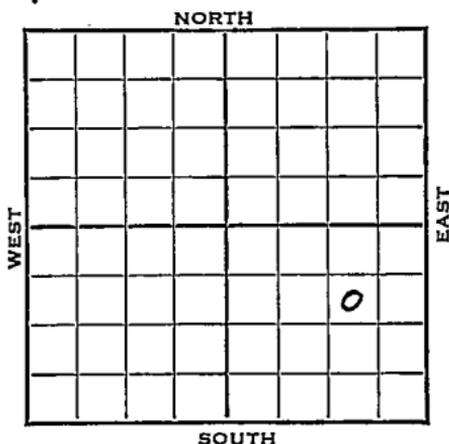

1943

### REPORT

3/3	Drlg. 55'
3/10	10" Casing set 75' Drlg. 810'
3/16	Bart 1470 Miss 1518 TD 1528 fsg 6"
3/24	" " "
3/31	" " "
4/7	SD
4/14	Drlg. 1628'
4/21	Miss 1513. 6" @ 1557 T.D. 1659 PB 1562
4/28	Miss. 1513 6" @ 1557' T.D. 1659' P.B. 1562' 2000 gal. acid Pump 220 Pot. Gravity 26

## COMPLETED



KANSAS

Jefferson

Map No. 111 Sec. 5 Twp. 10 R. 20E

Well No. 4 McLebd

Young & Longwell Company

CORRECTION Contractor

SW NE SE

SECTION PLAT

990 Ft. from N. Line

Ft. from S. Line

990 Ft. from E. Line

Ft. from W. Line


MCLOUTH POOL

Location \_\_\_\_\_

Rig up \_\_\_\_\_

Drilling and Remarks:

Reported as

Longwell

#2 McLeod

RECORD

Cased \_\_\_\_\_ ft.

Sand \_\_\_\_\_

Gas \_\_\_\_\_

Oil \_\_\_\_\_

Total Depth \_\_\_\_\_

PRODUCTION

1st 24 hrs. Nat. \_\_\_\_\_

1st 24 hrs. after shot \_\_\_\_\_

Gas \_\_\_\_\_ Cu. Ft.

Dry Hole \_\_\_\_\_

Abandoned \_\_\_\_\_

Date

MAR 10 1943 19

S. J. LEWIS Scout

KANSAS Jefferson  
 Map No. 1777 Sec. 5 Twp. 10 R. 20E  
 Well No. 4 McLeod

Young & Longwell Company

COMPLETED Contractor

SW NE SE


SECTION PLAT

990 Ft. from N. Line

\_\_\_\_\_ Ft. from S. Line

990 Ft. from E. Line

\_\_\_\_\_ Ft. from W. Line

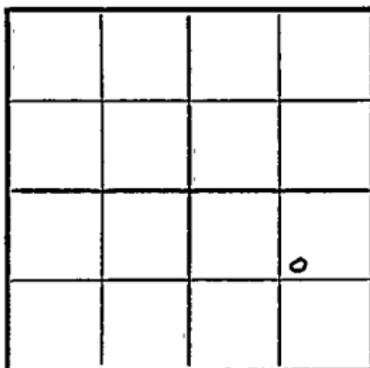

MCLOUTH POOL

Location \_\_\_\_\_

Rig up \_\_\_\_\_

Drilling and Remarks:

*11/15/13*

*6" @ 155'*

*PB 1562*

*2000 acid*

*Pump 220 P & X*

*260 gal*

RECORD

Cased \_\_\_\_\_ in., \_\_\_\_\_ ft.

Sand \_\_\_\_\_

Gas \_\_\_\_\_

Oil \_\_\_\_\_

Total Depth: 1659

PRODUCTION

1st 24 hrs. Nat. \_\_\_\_\_

1st 24 hrs. after shot \_\_\_\_\_

Gas \_\_\_\_\_ Cu. Ft.

Dry Hole \_\_\_\_\_

Abandoned \_\_\_\_\_

Date

APR 28 1943 19

S. J. LEWIS Scout