

KANSAS


FORM 51 5M PETROL

Jefferson

Section 5 Township 10 Range 20-E

Well No. #5 McLeod

Company Jackson

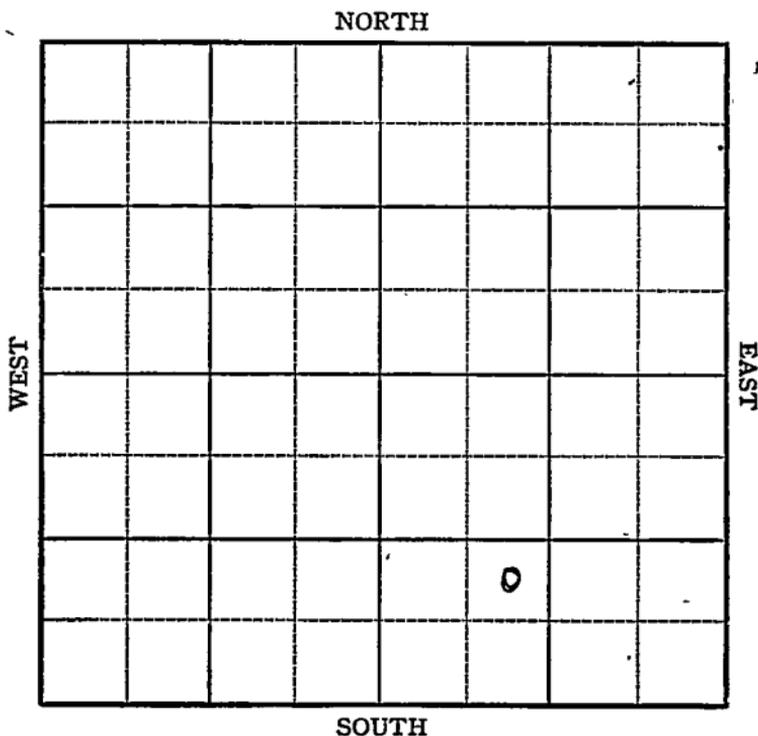

Sec. 5 Twp. 10 R. 20-E

Well No. #5 McLeod Farm


Jackson Company

 Ft. from N. Line

990 Ft. from S. Line

 Ft. from E. Line

990 Ft. from W. Line

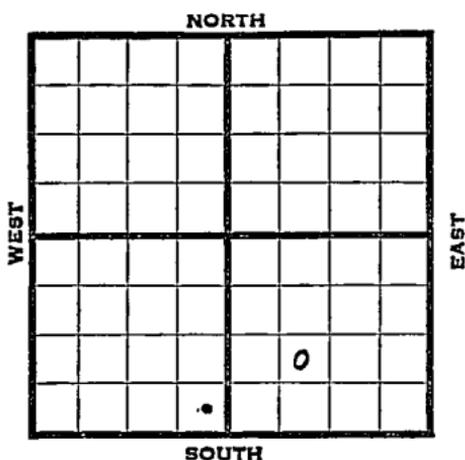

Elev. 1163

1943

REPORT

9/1	Machine
9/8	40' SD
9/15	10" @ 87' Drlg. 785'
9/22	Drlg. 1020' 8" @ 965'
9/29	6" @ 1508' sand Sand 1505 Miss 1576 Drlg. 1586'
10/6	Drlg. 1592' fsg.
10/13	" " "
10/20	" " "
10/27	" " "
11/3	" " "
11/10	" " "
11/17	5" @ 1584 Drlg. 1650'
12/1	1650 fsg.
12/8	TD 1675 97' of 4" Perf Liner on Bottom

1943
12-15 2000 acid
20 fluid
VSSO in 3/4 hrs.
12/22 " " "
12/29 " "
1944
1-5 " "
1-12 TD 1685' SSO
1/19 Miss 1576'
5" @ 1584'
TD 1685'

ABANDONED

no more

Misc Small Maps	<i>No. Small Map One</i>
Cards	<i>Book</i>
Tracing	
France Map	
Scarborough Map	<i>X</i>
Moody Map	
Geological Dept.	
Moody Flat Book	

))

no wood

Misc. Small Maps
Cards
Tracing
France Map
Scarborough Map
Moody Map
Crological Dept.
Moody Plnt Book

Misc. Small Map - Omaha

Madge

X