

KANSAS

Jefferson County

Section 5 Township 10 Range 20EWell No. #5 McLeodCompany Chas Miller

McLouth

NORTH

WEST

EAST

SOUTH

9

KANSAS

Jefferson County

Sec. 5 Twp. 10 R. 20E

Well No. #5 McLeod Farm

Chas Miller - Company


McLouth

660 Ft. from N. Line

° Ft. from S. Line

330 Ft. from E. Line

° Ft. from W. Line

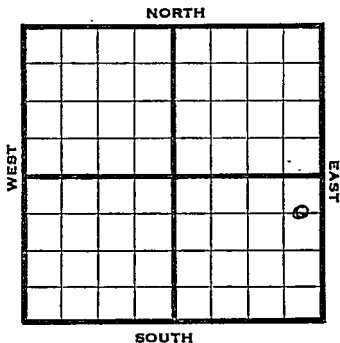

C E L N E S E

1944

R E P O R T

10/4

10" - 38'
8" - 900'
Miss 1466
6" - 1455'
TD 1619
40 bbls oil

**FIRST REPORT
/ COMPLETED**

KANSAS

Pool Name McLouthMap No. VM Sec. 5 Twp. 10 R. 20EWell No. 5 McLeod

Chas Miller

Company

FIRST REPORT

~~COMPLETED~~

Contractor

C E L N E S E

SECTION PLAT

660 Ft. from N. Line Ft. from S. Line330 Ft. from E. Line Ft. from W. Line

			o

Jefferson County

Location

Rig up

Drilling and Remarks:

10"-38"

8"-900

Miss 1466

6"-1455

TD 1619

40 bbls. oil

RECORD

Cased in., ft.

Sand

Gas

Oil

Total Depth 1619

PRODUCTION

1st 24 hrs. Nat. 1st 24 hrs. after shot Gas Cu. Ft.Dry Hole Abandoned

Date

OCT 4 1944

19

S. J. LEWIS

Scout