

KANSAS

FORM 51 5M 10-41 PETROL


Jefferson

Section 5 Township 10 Range 20-E

Well No. #2 Bower

Company Apperson

McLouth Pool

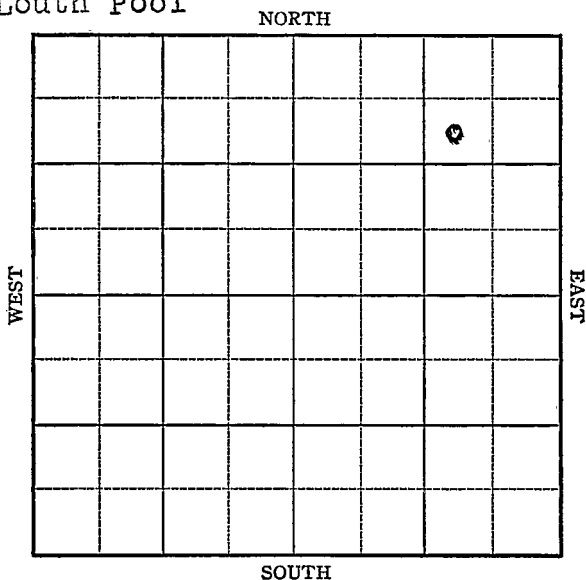

KANSAS

Jefferson

Sec. 5 Twp. 10 R. 20-E

Well No. #2 Bower Farm

Apperson Company


McLouth Pool

990, Ft. from N. Line

Ft. from S. Line

990 Ft. from E. Line

Ft. from W. Line

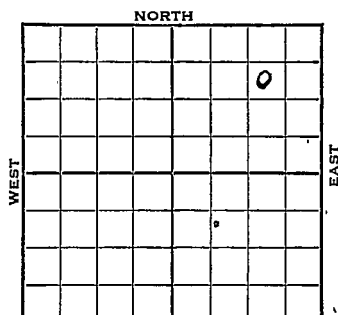

SW NE NE Elev. 1137

1942

REPORT

12/2	Loc.
12/9	"
12/16	Spud
12/22	10" @ 72'
	Drlg. 580'
12/29	Drlg. 970' 8" - 953"
1943	
1/6	983 SD
1/13	Drlg. 1310'
1/20	Sand 1310
	6" Casing set 1450'
	TD 1460' SD.
1/27	" " "
2/3	Miss. 1511
	SSO 1643
	Drlg. 1650'
2/10	TD 1651' SD
2/17	" " "
2/24	Miss. 1511
	T.D. 1651'
	No shows.

ABANDONED

KANSAS

Jefferson

Map No. MM Sec. 5 Twp. 10 R. 20EWell No. 2 Bower

Appers on _____

Company _____

FIRST REPORT

Contractor _____

SW NE NE

SECTION PLAT

990 Ft. from N. Line

_____ Ft. from S. Line

990 Ft. from E. Line

_____ Ft. from W. Line

			o

MCLOUTH POOL

Location XXX

Rig up _____

Drilling and Remarks:

RECORD

Cased _____ in., _____ ft.

Sand _____

Gas _____

Oil _____

Total Depth _____

PRODUCTION

1st 24 hrs. Nat. _____

1st 24 hrs. after shot _____

Gas _____ Cu. Ft.

Dry Hole _____

Abandoned _____

Date

DEC 2 1942S. I. LEWIS Scout

KANSAS

Map No. 111 Sec. 5 Twp. 10 R. 20EWell No. 2 BowerApperson

Company

ABANDONED

Contractor

SW NE NE

SECTION PLAT

990 Ft. from N. Line

Ft. from S. Line

990 Ft. from E. Line

Ft. from W. Line

			σ

MCLOUTH POOL

Location

Rig up

Drilling and Remarks:

*Miss 1511**No loss*

RECORD

Cased _____ in., _____ ft.

Sand _____

Gas _____

Oil _____

Total Depth 1651

PRODUCTION

1st 24 hrs. Nat. _____

1st 24 hrs. after shot _____

Gas _____ Cu. Ft.

Dry Hole _____

Abandoned _____

Date

FEB 24 1943

19

S. J. LEWIS

Scout