

KANSAS


FORM 51 5M 10-41 PETROL

Leavenworth

Section 6 Township 10 Range 21-E

Well No. #3 Bell

Company C. E. Miller Magnolia

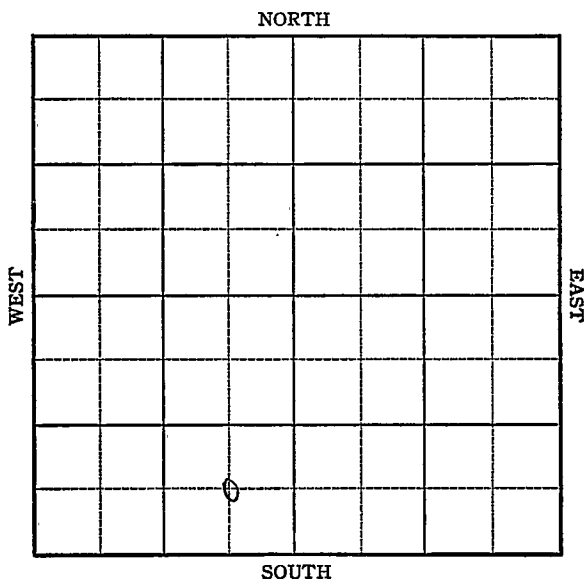

14

L & S 1034

KANSAS

Leavenworth

Sec. 6 Twp. 10 R. 21-E

Well No. #3 Bell Farm

~~C. E. Miller~~ Magnolia Company


. McClouth

 Ft. from N. Line

660 Ft. from S. Line

660 Ft. from E. Line

 Ft. from W. Line

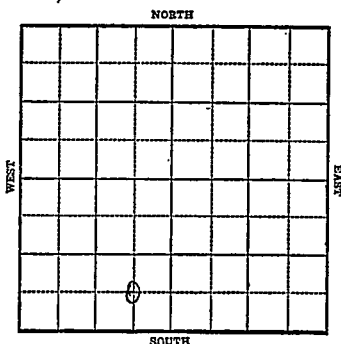

C SE SW

1943

R E P O R T

2/24 Location.

3/3 Sand 1408 set 1328'
Miss 1418 ls oil in 24 hrs.
TD 1420 1 bailer oil per hr.
3/10 " " " " " "

3/16 7" Casing set 1421
TD 1433
500' oil & 200' Wtr fsg.

3/24 7" @ 1405 corrected 70 qts 1406-21 CO.

3/31 Miss 1418
7" @ 1405'
70 qts 1406-21
Pump 20 Pot.
T.D. 1433'

COMPLETED

Leavenworth

KANSAS

Map No. MM Sec. 6 Twp. 10 R. 21EWell No. 3 BellC. E. Miller

Company

FIRST REPORT

Contractor

C SE SW

SECTION PLAT

 Ft. from N. Line660 Ft. from S. Line660 Ft. from E. Line Ft. from W. Line

MCLOUTH POOL

Location XXXRig up

Drilling and Remarks:

RECORD

Cased in., ft.Sand Gas Oil Total Depth

PRODUCTION

1st 24 hrs. Nat. 1st 24 hrs. after shot Gas Cu. Ft.Dry Hole Abandoned

Date

FEB 24 1943 19S. J. LEWIS Scout

KANSAS

Leavenworth

Map No. MM Sec. 6 Twp. 10 R. 21EWell No. 3 BellMagnolia

Company

CORRECTION

Contractor

C SE SW

 Ft. from N. Line660 Ft. from S. Line660 Ft. from E. Line Ft. from W. Line

SECTION PLAT

MCLOUTH POOL

Location Rig up

Drilling and Remarks:

Reported as

C. E. Miller

Magnolia takes

these wells over

if they produce

oil

RECORD

Cased in. ft.Sand Gas Oil Total Depth

PRODUCTION

1st 24 hrs. Nat. 1st 24 hrs. after shot Gas Cu. Ft.Dry Hole Abandoned

Date

MAR 3 194319S. J. LEWIS

Scout

Leavenworth

KANSAS
 Map No. WV Sec. 6 Twp. 10 R. 21E

Well No. 3 BellMagnolia

Company

COMPLETED

Contractor

C SE SW

SECTION PLAT

_____ Ft. from N. Line

660 Ft. from S. Line660 Ft. from E. Line

_____ Ft. from W. Line

MCLOUTH POOL

Location _____

Rig up _____

Drilling and Remarks:

*Miss 1418.**7" @ 1405.**709 to 1406-21**Prod. 20 Bx.**26 Bx.*

RECORD

Cased _____ in. _____ ft.

Sand _____

Gas _____

Oil _____

Total Depth 1439

PRODUCTION

1st 24 hrs. Nat. _____

1st 24 hrs. after shot _____

Gas _____ Cu. Ft.

Dry Hole _____

Abandoned _____

Date

MAR 31 1943

19

S. J. LEWIS

Scout